
FORM 51 25M 3-49 PETROL KANSAS Coffey

Section 17 Township 23 Range 14E

Well No. 1 Fisher

Company J.R. Robertson

Misc.

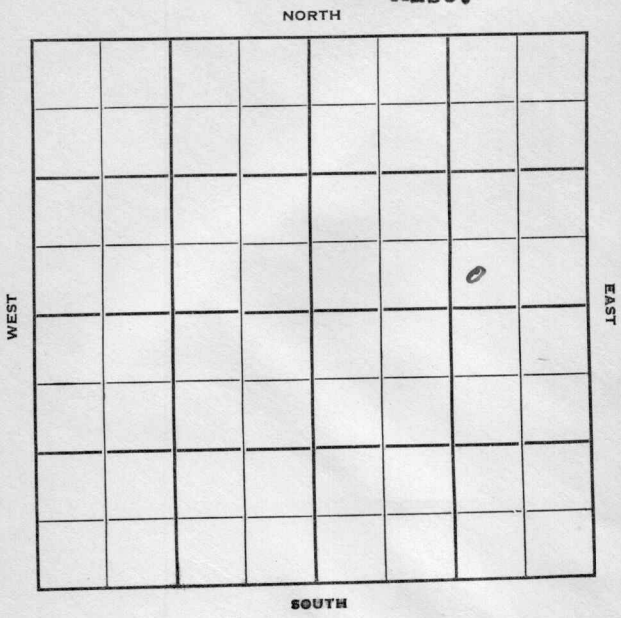

FORM 252-A
5M 10-48 PETROL


Coffey KANSAS

Sec. 17 Twp. 23 R. 14E

Well No. #1 Fisher Farm

J. R. Robertson Company

Miscellaneous (French, Cont.)

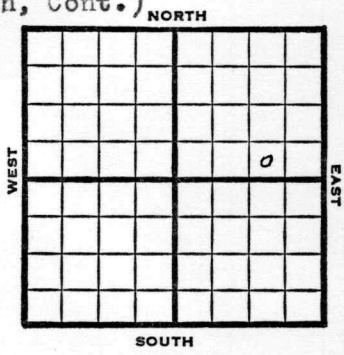

Ft. from N. Line

330' Ft. from S. Line

990' Ft. from E. Line

Ft. from W. Line

SW SE NE

1949	REPORT
10/19	8" @ 74' Drlg. 1269'
10/26	Miss 1547' 5" @ 1547' TD 1689'
11/1	"
11/9	TD 1690' Miss 1547' 5"@ 1547' 2000 acid Pump 10 Oil / 10 W Pot 36° Gr. Comp COMPLETED

Form 26 200 Bks. 6-49 Petrol

Miscellaneous

Kansas

Map No. _____ Sec. 17 Twp. 23 R. 14E

Well No. 1 Fisher


J. R. Robertson Company

French Contractor

SW SE NE

FIRST REPORT

SECTION PLAT

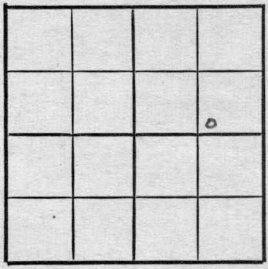

_____ Ft. from N. Line

330 Ft. from S. Line

990 Ft. from E. Line

_____ Ft. from W. Line

Coffey County

Location

Rig up

Drilling and Remarks:

8" @ 74

drlg. 1269

RECORD

Cased _____ in., _____ ft.

Sand

Gas

Oil

Total Depth

PRODUCTION

1st 24 hrs. Nat.

1st 24 hrs. after shot

Gas _____ Cu. Ft.

Dry Hole

Abandoned

Date

OCT 19 1949 19

S. J. LEWIS Scout

Form 26 200 Bks. 6-49 Petrol

Miscellaneous

Kansas

Map No. _____ Sec. 17 Twp. 23 R. 14E


Well No. 1 Fisher

J. R. Robertson Company

COMPLETE Contractor

SW SE NE

SECTION PLAT

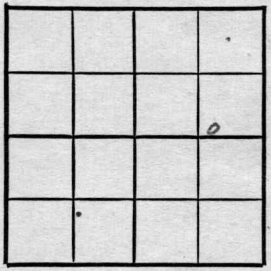

_____ Ft. from N. Line

330 Ft. from S. Line

990 Ft. from E. Line

_____ Ft. from W. Line

Coffey County

Location _____

Rig up _____

Drilling and Remarks:

Miss 1547

5" @ 1547

200 acid

Pump 10 oil + 10 water

36 2/4

RECORD

Cased _____ in., _____ ft.

Sand _____

Gas _____

Oil _____

Total Depth 1690

PRODUCTION

1st 24 hrs. Nat. _____

1st 24 hrs. after shot _____

Gas _____ Cu. Ft.

Dry Hole _____

Abandoned _____

Date

NOV 9 1949 19

S. J. LEWIS Scout