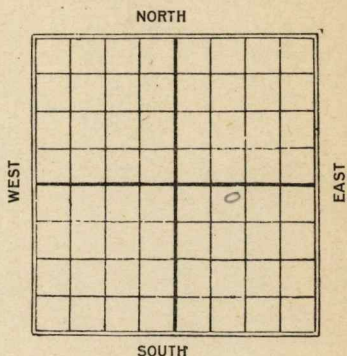


Map No. Kansas Sec. 30 Twp. 24 R. 11Well No. 1 Wiggins FarmMc Ginnis et al Company200 Ft. from N. Line

Ft. from S. Line

Ft. from E. Line

1120 Ft. from W. Line

C

Date

REPORT

19253/24 Location

5/29 Sand 1552-72' - TD ⁸⁴15~~42~~ SLM shot 70
 gts pumped 70 blbls 1st 24 hrs.
 40 blbls 2nd 24 hrs.

6/5 S1553-72 - TD. 1584 70/70 1st 24 hrs 4000

16
 Map No. **KANSAS** Sec. 30 Twp. 24 R. 11

 Well No. 1 Wiggins
Mc Ginnis et al Company

_____ Contractor

FIRST REPORT**SECTION PLAT**
200' Ft. from N. Line

_____ Ft. from S. Line

_____ Ft. from E. Line

1120 Ft. from W. Line

		o	

 Location ✓ ✓

Rig up _____

Drilling and Remarks:

RECORD

Cased _____ in., _____ ft.

Sand _____

Gas _____

Oil _____

Total Depth _____

PRODUCTION

1st 24 hrs. Nat. _____

1st 24 hrs. after shot _____

Gas _____ Cu. Ft.

Dry Hole _____

Abandoned _____

Date

3/24 1925
M. A. BENEAR

Scout

Map No. 20 Sec. 30 Twp. 24 R. 11Well No. 1 WigginsMc Innis & Co Company

Contractor

SECTION PLAT

200 Ft. from N. Line

Ft. from S. Line

Ft. from E. Line

1120 Ft. from W. Line

COMPLETED

		o	

Location

Rig up

Drilling and Remarks:

RECORD

Cased _____ in., _____ ft.

Sand 1553-1572'

Gas _____

Oil _____

Total Depth 1584'

PRODUCTION

1st 24 hrs. Nat. _____

1st 24 hrs. after shot _____

Gas _____ Cu. Ft.

Dry Hole _____

Abandoned _____

Date

JUN 5 1925

192

CHAS. L. SHERWOOD

Scout

70/70 bbls 1st 24 hrs.

now pumping 40 bbls.