


Map No. Kan Sec. 30 Twp. 24 R. 11

Well No. 1 Higgins Farm
Ward Mc Ginnis Company

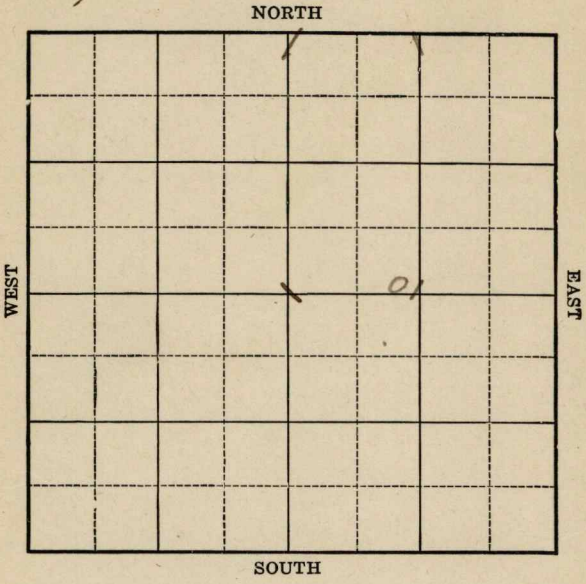

Location _____
Drilling Remarks _____

Rig Up _____
Drilling Remarks _____

RECORD

Cased _____ in. _____ ft.
Sand _____
Gas _____
Oil _____
Total Depth _____

PRODUCTION


1st 24 hrs. Nat. _____
1st. 24 hrs. after shot _____
Gas _____ cu. ft.
Dry Hole _____
Abandoned _____

Map No. Kans Sec. 30 Twp. 24 R. 11Well No. 1 Higgins Farm
Ward - Ma Gunnis Company

Ft. from N. Line

330 Ft. from S. Line

Ft. from E. Line

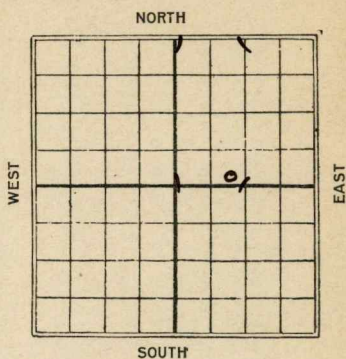990 Ft. from W. LineDate 1925 REPORT7/10 Timbers7/17 Rig7/24 Spudding.7/31 —8/7 ~~500~~ 13008/14 Top of 15 82-1602 TH8/20 80 gts pipe trouble8/27 same9/3 —9/11 have hole clean9/16 swabbing no est.9/24 —10/1 Sand 1582-1602T.D. 1607 80 gts 15 Bbls

Map No. 16 Sec. 30 Twp. 24 R. 11

Well No. 1 Weggen

Hard Mc Ginnis Company

Contractor

FIRST REPORTS

Ft. from N. Line

330

Ft. from S. Line

Ft. from E. Line

996

Ft. from W. Line

SECTION PLAT

Location Timber

Rig up Timber

Drilling and Remarks:

RECORD

Cased _____ in., _____ ft.

Sand _____

Gas _____

Oil _____

Total Depth _____

PRODUCTION

1st 24 hrs. Nat. _____

1st 24 hrs. after shot _____

Gas _____ Cu. Ft.

Dry Hole _____

Abandoned _____

Date

JUL 10 1925

CHAS. L. SHERWOOD

192

Scout


16 KANSAS 30 Twp. 24 R. 11

Well No. 1 Higgins
Ward Mc Ginnis Company

Contractor

COMPLETED

SECTION PLAT

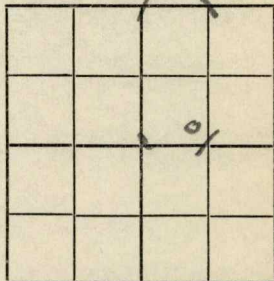

Ft. from N. Line

330

Ft. from S. Line

Ft. from E. Line

990

Ft. from W. Line

Location

Rig up

Drilling and Remarks:

80/15 bhs

RECORD

Cased in., 1602 ft.

Sand 1582-1602

Gas

Oil

Total Depth 1607

PRODUCTION

1st 24 hrs. Nat.

1st 24 hrs. after shot

Gas Cu. Ft.

Dry Hole

Abandoned

Date

OCT 1 1925

192

CHAS. L. SHERWOOD

Scout