


Hoodson
 Map No. KANSAS Sec. 20 Twp. 23 R. 14E
 Well No. 1-McCluskey Farm
O. J. Smith & Sinclair Company

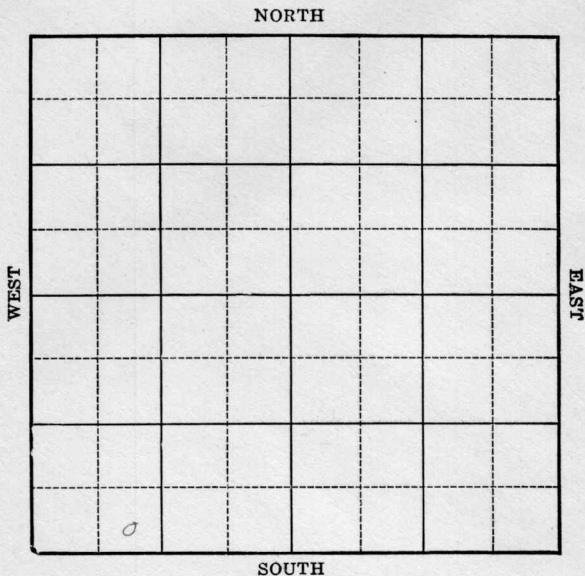

Location _____
 Drilling Remarks _____

Rig Up _____
 Drilling Remarks _____

RECORD

Cased _____ in. _____ ft.
 Sand _____
 Gas _____
 Oil _____
 Total Depth _____

PRODUCTION

1st 24 hrs. Nat. _____
 1st 24 hrs. after shot _____
 Gas _____ cu. ft.
 Dry Hole _____
 Abandoned _____

Map No. KANSAS Sec. 20 Twp. 23 R. 14^E

Well No. 1-M^c Closkey Farm

R. J. Smith & Sinclair Company


 Ft. from N. Line

250 Ft. from S. Line

 Ft. from E. Line

1100 Ft. from W. Line

1932

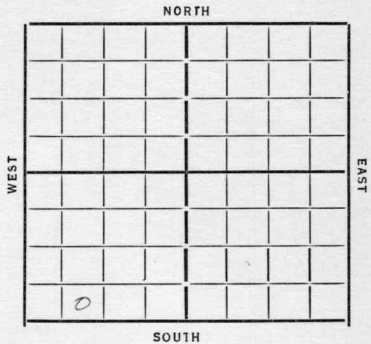

Date

REPORT

12/21	Run up mach
12/28	SD 850'
1933	
1/4	
1/11	Land 1661-89
	TD 1689
	shot 60 qt
	No test
1/18	TD 1689
	P.B. 1686
	shot 60 qt 1663-85
	swab test) 75 bbl
1/25	Land 1661-89
	TD 1689
	P.B. 1686
	shot 60 qt 1663-85
	pump 30 bbl
	Comp.

17 *Nooden*
 Map No. *KANSAS* Sec. *20* Twp. *23* R. *14* E

Well No. *1* *McClaskey*

R. J. Smith & Sinclair Company

Contractor

FIRST REPORTS

.....Ft. from N. Line

750Ft. from S. Line

.....Ft. from E. Line

1100Ft. from W. Line

SECTION PLAT

Location.....

Rig up.....

Drilling and Remarks:

*Rigging up
 Machine.*

RECORD

Cased.....in.,ft.

Sand.....

Gas.....

Oil.....

Total Depth.....

PRODUCTION

1st 24 hrs. Nat.....

1st 24 hrs. after shot.....

Gas.....Cu. Ft.

Dry Hole.....

Abandoned.....

Date

DEC 21 1932

CHAS. L. SHERWOOD

192.....

Scout

Hoodsen

17 KANSAS

Map No. Sec. 20 Twp. 23 R. 14 E

Well No. 1 Mc Classkey

R. J. Smith & Sinclair Company

Contractor

COMPLETED

SECTION PLAT

Ft. from N. Line

250 Ft. from S. Line

Ft. from E. Line

1100 Ft. from W. Line

Location

Rig up

Drilling and Remarks:

P.B. 1686

Shot 60/1663-85

Pump 30 Blo.

RECORD

Cased in., ft.

Sand 1661-1689

Gas

Oil

Total Depth 1689

PRODUCTION

1st 24 hrs. Nat.

1st 24 hrs. after shot

Gas Cu. Ft.

Dry Hole

Abandoned

Date

JAN 25 1933

CHAS. L. SHERWOOD

192

Scout