


Woodson

Form 51-5M-2-29-34703

Map No. KANSAS Sec. 20 Twp. 23 R. 14

Well No. Okla Beef 24 R Farm Company

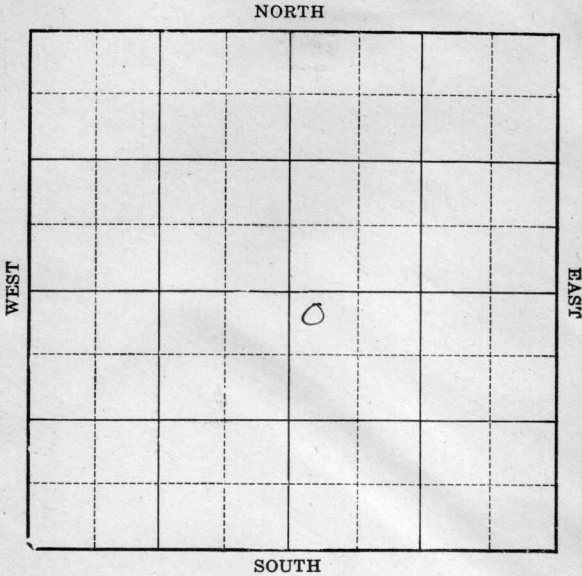

Location _____
Drilling Remarks _____

RECORD

Cased _____ in. _____ ft.
Sand _____
Gas _____
Oil _____
Total Depth _____

Rig Up _____
Drilling Remarks _____

PRODUCTION

1st 24 hrs. Nat. _____
1st 24 hrs. after shot _____
Gas _____ cu. ft.
Dry Hole _____
Abandoned _____

Woodson

Map No. _____ Sec. 20 Twp. 23 R. 14Well No. 1 DeerOklahoma PRR Company

Contractor

FIRST REPORTS

Ft. from N. Line

Ft. from S. Line

Ft. from E. Line

Ft. from W. Line

COMPLETED

SECTION PLAT

		o	

Location _____

Rig up _____

Drilling and Remarks:

Small Producer.

RECORD

Cased _____ in., _____ ft.

Sand 1651-1663

Gas _____

Oil _____

Total Depth 1663

PRODUCTION

1st 24 hrs. Nat. _____

1st 24 hrs. after shot _____

Gas _____ Cu. Ft.

Dry Hole _____

Abandoned _____

Date

11/5/20 192Sherwood Scout