


Map No. Kansas Greenwood Sec. 30 Twp. 24 R. 11

Well No. 5th Higgins Farm

Ward Mc Linnis Company

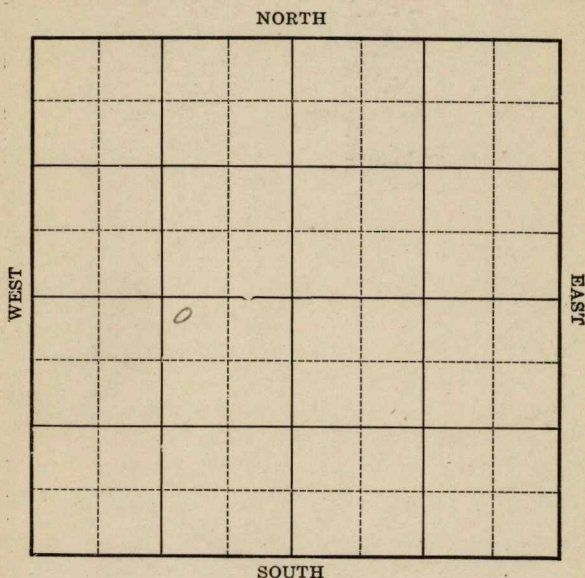

Location _____

Drilling Remarks

RECORD

Cased _____ in. _____ ft.

Sand _____

Gas _____

Oil _____

Total Depth _____

Rig Up _____

Drilling Remarks

PRODUCTION

1st 24 hrs. Nat. _____

1st 24 hrs. after shot _____

Gas _____ cu. ft.

Dry Hole _____

Abandoned _____

Map No. Name Sec. 30 Twp. 24 R. 11

Well No. 5th Urgent Farm

Ward McKinnis Company

NORTH

Ft. from N. Line

Ft. from S. Line

Ft. from E. Line

Ft. from W. Line

WEST

EAST

SOUTH

Date _____

REPORT

2/25	Location
------	----------

411	—
-----	---

4/7	
-----	--

4/14

4/21	
------	--

4/30	_____
------	-------

5/8	Done
-----	------

1.	
5/12	_____

5/19 Rig

6/2 Drdg. 1000.

6/10 Sand 1786-1826' 1200' oil in
hole natural, shot 100 gta
bridged

6/17	Sand 1796-1826	100 gte
	630 bbls	

Robertwood
 K16 KANSAS
 Map No. _____ Sec. *30* Twp. *24* R. *11*
 Well No. *5a* *Higgins*
Hard Mc Ginnes Company

Contractor

FIRST REPORTS

SECTION PLAT

330 Ft. from N. Line

_____ Ft. from S. Line

990 Ft. from E. Line

_____ Ft. from W. Line

	o		

✓
 Location _____

Rig up _____

Drilling and Remarks:

RECORD

Cased _____ in., _____ ft.

Sand _____

Gas _____

Oil _____

Total Depth _____

PRODUCTION

1st 24 hrs. Nat. _____

1st 24 hrs. after shot _____

Gas _____ Cu. Ft.

Dry Hole _____

Abandoned _____

Date

MAR 25 1926

CHAS. L. SHERWOOD

192

Scout

K16 **KANSAS** *30* **Map No.** *24* **Sec.** *11* **Twp.** *Wiggins* **R.**
59 **Well No.** *Ward Mc Ginnis* **Company**

COMPLETED

SECTION PLAT

330 **Ft. from N. Line**
Ft. from S. Line
990 **Ft. from E. Line**
Ft. from W. Line

	10		

Location -----
Rig up -----
Drilling and Remarks:

100/630 BS.

RECORD

Cased ----- **in.,** ----- **ft.**
Sand *1796-1826*
Gas -----
Oil -----
Total Depth *1826*

PRODUCTION

1st 24 hrs. Nat. -----
1st 24 hrs. after shot -----
Gas ----- **Cu. Ft.**
Dry Hole -----
Abandoned -----

Date

JUN 17 1926 *192* **CHAS. L. SHERWOOD** **Scout**