


Map No. *K* Sec. *30* Twp. *24* R. *11*
 Well No. *6* *Wiggins "A"* Farm
McGinnis et al Company

NORTH

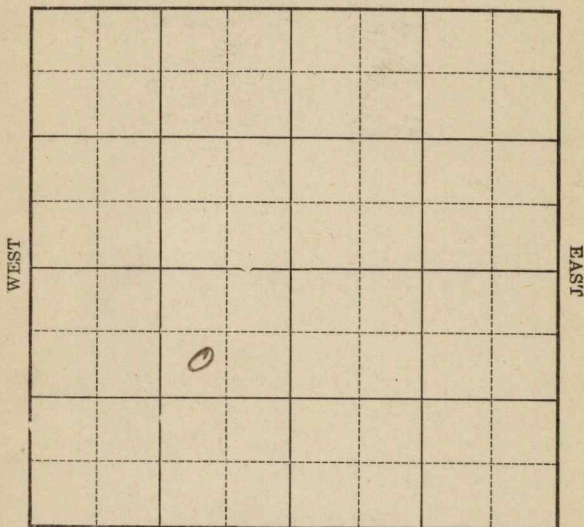

SOUTH

Location _____

Drilling Remarks

Rig Up _____

Drilling Remarks

RECORD

Cased _____ in. _____ ft.

Sand _____

Gas _____

Oil _____

Total Depth _____

PRODUCTION

1st 24 hrs. Nat. _____

1st 24 hrs. after shot _____

Gas _____ cu. ft.

Dry Hole _____

Abandoned _____

Greenwood

Map No. Kansas Sec. 30 Twp. 24 R. 11Well No. 6 Wiggins "A" FarmMc Ginnis et al Company


NORTH

990 Ft. from N. Line

Ft. from S. Line

990 Ft. from E. Line

Ft. from W. Line

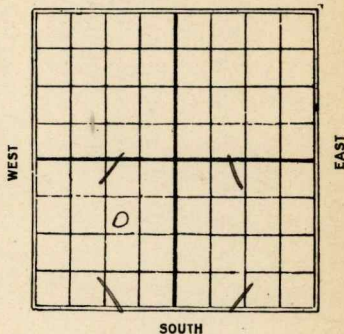

Date

REPORT

19264/24 Rig up6-30 —7/8 —7/15 —7/22 Rigging up7/28 Dlg 650 ft.8/4 Sand 1819-1847

100/200 bbls. T.D. 1847

Shenwood
 1516 KANSAS Sec. *30* Twp. *24* R. *11*
 Map No. *6* *Miggins "H"*
 Well No. *Mc Ginnis et al* Company
 Contractor

FIRST REPORTS

SECTION PLAT

990 Ft. from N. Line

_____ Ft. from S. Line

990 Ft. from E. Line

_____ Ft. from W. Line

	<i>o</i>		

Location _____

Rig up ☒ _____

Drilling and Remarks:

RECORD

Cased _____ in., _____ ft.

Sand _____

Gas _____

Oil _____

Total Depth _____

PRODUCTION

1st 24 hrs. Nat. _____

1st 24 hrs. after shot _____

Gas _____ Cu. Ft.

Dry Hole _____

Abandoned _____

Date

JUN 24 1926

CHAS. L. SHERWOOD

192

Scout

Greenwood
 K16 KANSAS *30* Sec. *24* Twp. *11*
 Map No. _____
 Well No. *Mc Ginnis et al* _____
 _____ Company

_____ Contractor

COMPLETED

SECTION PLAT

990 _____ Ft. from N. Line

_____ Ft. from S. Line

990 _____ Ft. from E. Line

_____ Ft. from W. Line

	0		

Location _____

Rig up _____

Drilling and Remarks:

100' 200' 185'

RECORD

Cased *1819-1847* in., *1847* ft.

Sand _____

Gas _____

Oil _____

Total Depth *1847* _____

PRODUCTION

1st 24 hrs. Nat. _____

1st 24 hrs. after shot _____

Gas _____ Cu. Ft.

Dry Hole _____

Abandoned _____

Date **AUG** 4 1926

CHAS. L. SHERWOOD

192

Scout