
Form 51-5M-12-36 Com'l

Woodson KANSAS

Section 20 Township 23 Range 14-E

Well Number 9 Peek

Company Pure Oil

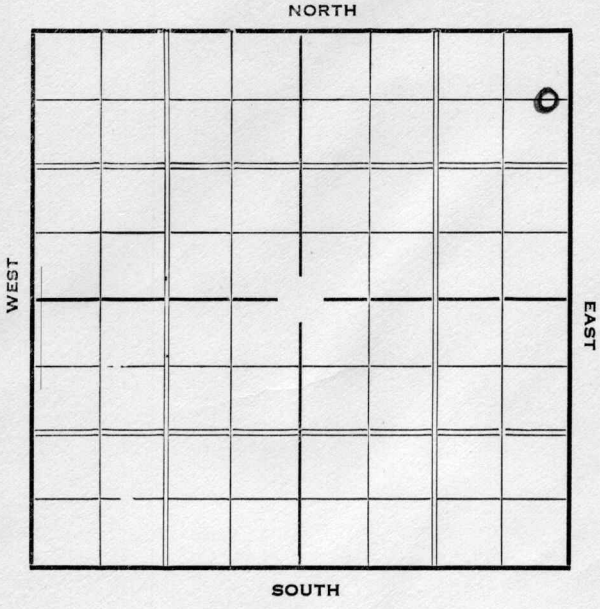

Form 252-A—5M—2-37—Palace KANSAS Woodson

Sec. 20 Twp. 23 R. 14-E

Well No. #9 Peek Farm


Pure Oil Company

660 Ft. from N. Line

Ft. from S. Line

220 Ft. from E. Line

Ft. from W. Line

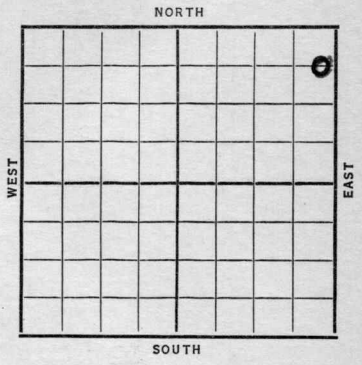

Date	REPORT
1937	
4/14	Location
4/23	"
4/30	Rig'n machine.
5/7	12" @ 34'. Drlg. 685'.
5/14	8" @ 1188'.
	Drlg. 1365'.
5/21	Miss. 1618-41'.T.D.
	6" @ 1619'. WOC.
5/26	6" @ 1619'.
	Miss. 1618'.
	T.D. 1641'.
	3000 acid.
	Pot. 23 bbls.
	COMPLETED

Form 26—1M Bks.—2-29 KANSAS Woodson


Map No. _____ Sec. 20 Twp. 23 R. 14E

Well No. 9 Peck

Pure Oil Company

_____ Contractor

SECTION PLAT

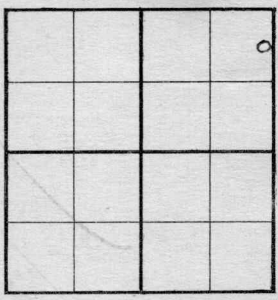

660 Ft. from N. Line

_____ Ft. from S. Line

220 Ft. from E. Line

_____ Ft. from W. Line

FIRST REPORT

Location ✓

Rig up _____

Drilling and Remarks:

RECORD

Cased _____ in., _____ ft.

Sand _____

Gas _____

Oil _____

Total Depth _____

PRODUCTION

1st 24 hrs. Nat. _____

1st 24 hrs. after shot _____

Gas _____ Cu. Ft.

Dry Hole _____

Abandoned _____

Date

APR 14 1937 19 _____

S. J. LEWIS Scout

Form 26—1M-Bks.—2-29 KANSAS Woodson

Map No. 17 Sec. 20 Twp. 23 R. 14 E

Well No. 9-Peek

Pure Oil Company

Contractor

COMPLETED


660 Ft. from N. Line

Ft. from S. Line

220 Ft. from E. Line

Ft. from W. Line

SECTION PLAT

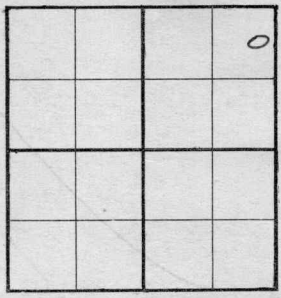

Location

Rig up

Drilling and Remarks:

3000 Acid

Pot 23

RECORD

Cased 6 in. 1619 ft.

~~Sand~~ Miss 1618

Gas

Oil

Total Depth 1641

PRODUCTION

1st 24 hrs. Nat.

1st 24 hrs. after shot

Gas Cu. Ft.

Dry Hole

Abandoned

Date

MAY 26 1937 19

H. D. Hatfield Scout