

Map No. _____ Sec. 16 Twp. 27 R. ✓Well No. 24 Scully Farm __________Prairie Company _____

NORTH

WEST

EAST

SOUTH

Location _____

Rig Up _____

Drilling Remarks:

Drilling Remarks:

RECORD

Cased _____ in _____ Ft.

Sand _____

Gas _____

Oil _____

Total Depth _____

PRODUCTION

1st 24 hrs. Nat. _____

1st 24 hrs. after shot _____

Gas _____ Cu. Ft.

Dry Hole _____

Abandoned _____

Map No. K11 Sec. 16 Twp. 27 R. 4
 Well No. 24 Scully Farm
Prairie Company

NORTH

WEST

EAST

SOUTH

Location _____
 Rig Up _____
 Drilling and remarks _____

○

RECORD

Cased _____ in. _____ Ft.
 Sand _____
 Gas _____
 Oil _____
 Total Depth _____

PRODUCTION

1st 24 hrs. Nat. _____
 1st 24 hrs. after shot _____
 Gas _____ Cu. Ft.
 Dry Hole _____
 Abandoned _____

FIRST REPORT

Date 4/17, 1917 Candiff Scout

Map No. _____ Sec. 16 Twp. 22 R. 4
 Well No. 24 Souley Farm _____
Prairie Company _____

NORTH

WEST

EAST

SOUTH

Location ✓Rig Up ✓

Drilling and remarks

RECORD

Cased _____ in. _____ Ft.

Sand _____

Gas _____

Oil _____

Total Depth _____

PRODUCTION

1st 24 hrs. Nat. _____

1st 24 hrs. after shot _____

Gas _____ Cu. Ft.

Dry Hole _____


Abandoned _____

Date

4/24, 191 7 Carb Scout

Map No. _____ Sec. 16 Twp. 27 R. 4
 Well No. 24 Sully Farm _____
Prairie Company _____

NORTH

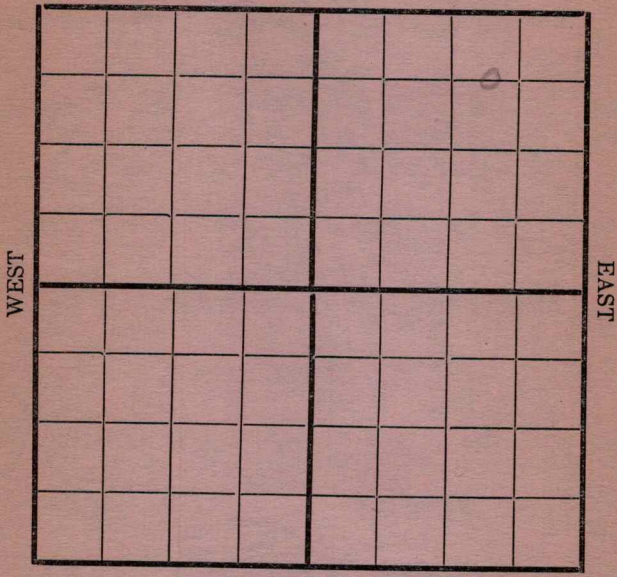

SOUTH

Location _____
 Rig Up ☒ _____
 Drilling and remarks _____

RECORD

Cased _____ in. _____ Ft.
 Sand _____
 Gas _____
 Oil _____
 Total Depth _____

PRODUCTION

1st 24 hrs. Nat. _____
 1st 24 hrs. after shot _____
 Gas _____ Cu. Ft.
 Dry Hole _____
 Abandoned _____

Date


5/2, 1917 C. C. Scott Scout

Map No. _____ Sec. 16 Twp. 27 R. 4
 Well No. 24 Scully Farm _____
Pririe Company _____

NORTH

WEST

EAST

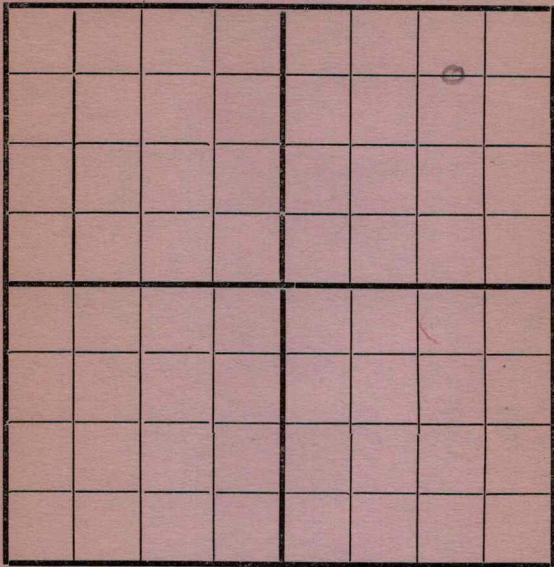

SOUTH

Location _____
 Rig Up ✓ _____
 Drilling and remarks _____

RECORD

Cased _____ in. _____ Ft.
 Sand _____
 Gas _____
 Oil _____
 Total Depth _____

PRODUCTION

1st 24 hrs. Nat. _____
 1st 24 hrs. after shot _____
 Gas _____ Cu. Ft.
 Dry Hole _____
 Abandoned _____


Date 3/7, 1917 Scout

Map No. _____ Sec. 16 Twp. 22 R. 4
Well No. 24 Sully Farm _____
Prarie Company _____

NORTH

WEST

EAST

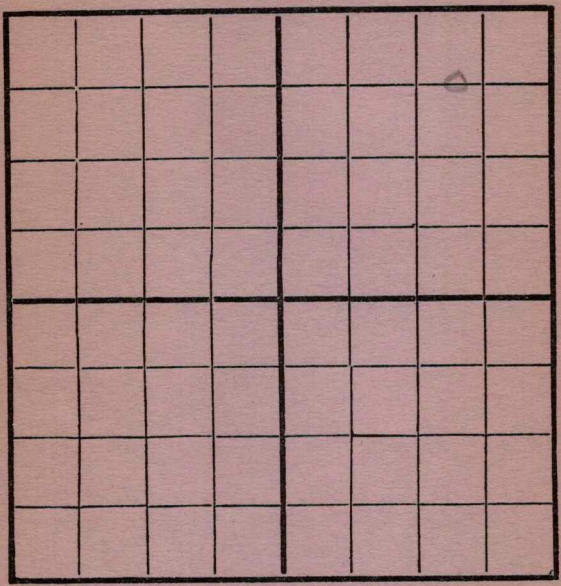

SOUTH

Location _____
Rig Up _____
Drilling and remarks

850

RECORD

Cased _____ in. _____ Ft.
Sand _____
Gas _____
Oil _____
Total Depth _____


PRODUCTION

1st 24 hrs. Nat. _____
1st 24 hrs. after shot _____
Gas _____ Cu. Ft.
Dry Hole _____
Abandoned _____

Date 5/30, 1917 Prarie Scout

Map No. _____ Sec. 16 Twp. 27 R. 4
 Well No. 24 - Sandy Farm _____
Pratt Company _____

NORTH

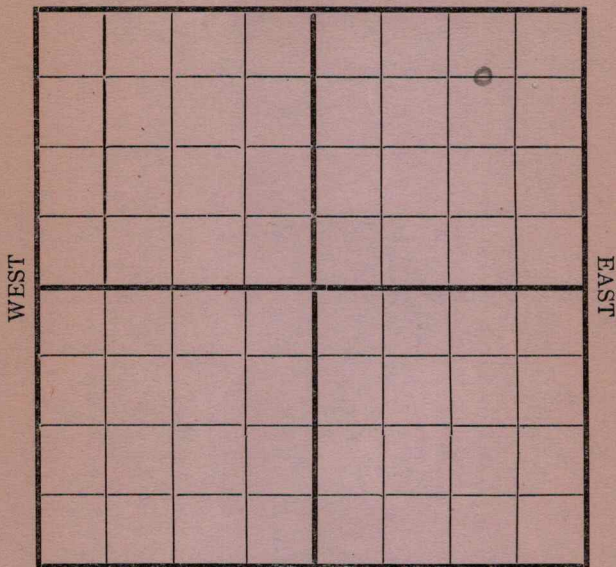

SOUTH

Location _____
 Rig Up _____
 Drilling and remarks _____

1385

RECORD

Cased _____ in. _____ Ft.
 Sand _____
 Gas _____
 Oil _____
 Total Depth _____


PRODUCTION

1st 24 hrs. Nat. _____
 1st 24 hrs. after shot _____
 Gas _____ Cu. Ft.
 Dry Hole _____
 Abandoned _____

Date 5/28, 1917 Candy Scout

Map No. _____ Sec. 16 Twp. 27 R. 4
Well No. 24 Sully Farm _____
Pririe Company _____

NORTH

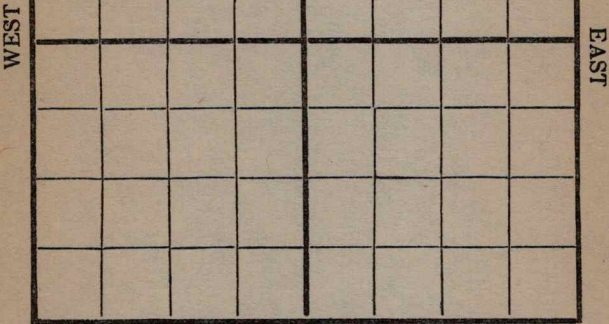

SOUTH


Location _____	RECORD
Rig Up _____	Cased _____ in. _____ Ft.
Drilling and remarks	Sand _____
<u>1700</u>	Gas _____
	Oil _____
	Total Depth _____
	PRODUCTION
	1st 24 hrs. Nat. _____
	1st 24 hrs. after shot _____
	Gas _____ Cu. Ft.
	Dry Hole _____
	Abandoned _____

Date 6/8, 1917, Candys Scout

Map No. _____ Sec. 16 Twp. 27 R. 4Well No. 24 Sully Farm _____Pioneer Company _____

NORTH

WEST

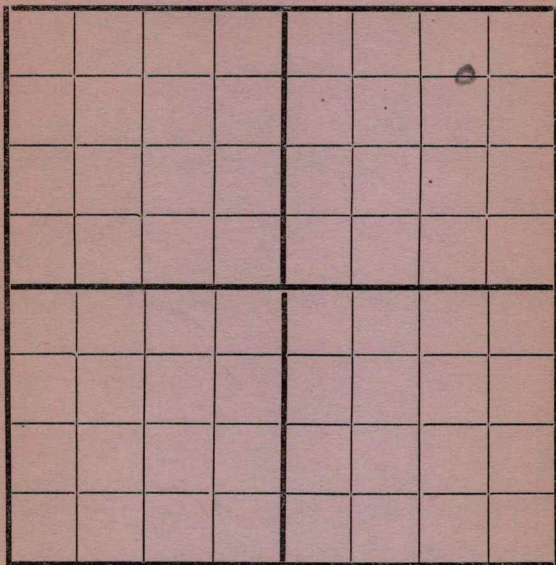

EAST

SOUTH

Location _____

Rig Up _____

Drilling and remarks

2160

RECORD

Cased _____ in. _____ Ft.

Sand _____

Gas _____

Oil _____

Total Depth _____

PRODUCTION

1st 24 hrs. Nat. _____

1st 24 hrs. after shot _____

Gas _____ Cu. Ft.

Dry Hole _____

Abandoned _____

Date

6/2


191

7Carley

Scout

Map No. _____ Sec. 16 Twp. 27 R. 4
 Well No. 24 Scully Farm _____
Provincie Company _____

NORTH

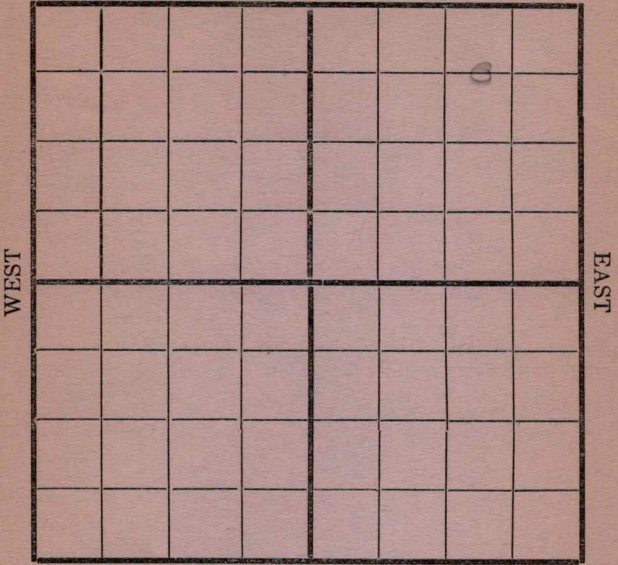

SOUTH

Location _____
 Rig Up _____
 Drilling and remarks _____

Shut Down
2/60

RECORD

Cased _____ in. _____ Ft.
 Sand _____
 Gas _____
 Oil _____
 Total Depth _____


PRODUCTION

1st 24 hrs. Nat. _____
 1st 24 hrs. after shot _____
 Gas _____ Cu. Ft.
 Dry Hole _____
 Abandoned _____

Date 6/20, 1917 Cully Scout

Map No. _____ Sec. 16 Twp. 22 R. 4
 Well No. 24 Scully Farm _____
Prossie Company _____

NORTH

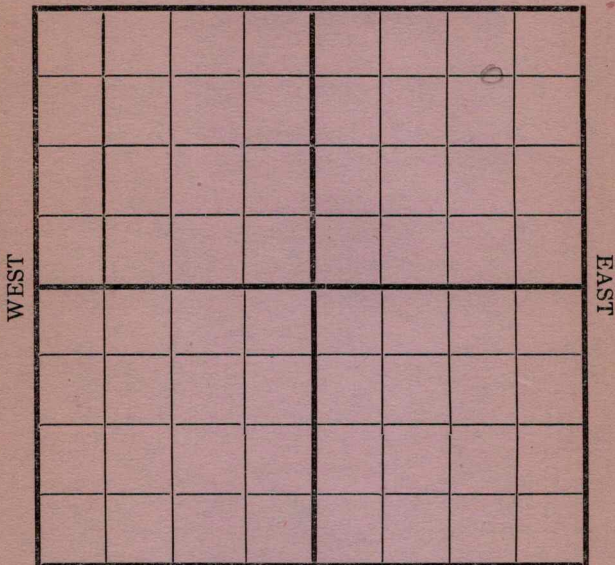

SOUTH

Location _____
 Rig Up _____
 Drilling and remarks _____

RECORD

Cased _____ in. _____ Ft.
 Sand _____
 Gas _____
 Oil _____
 Total Depth _____

PRODUCTION

1st 24 hrs. Nat. _____
 1st 24 hrs. after shot _____
 Gas _____ Cu. Ft.
 Dry Hole _____
 Abandoned _____


Date

6/27 1917 Cardiff Scout

Map No. _____ Sec. 16 Twp. 22 R. 4Well No. 24 Sully Farm
Prairie Company

NORTH

WEST

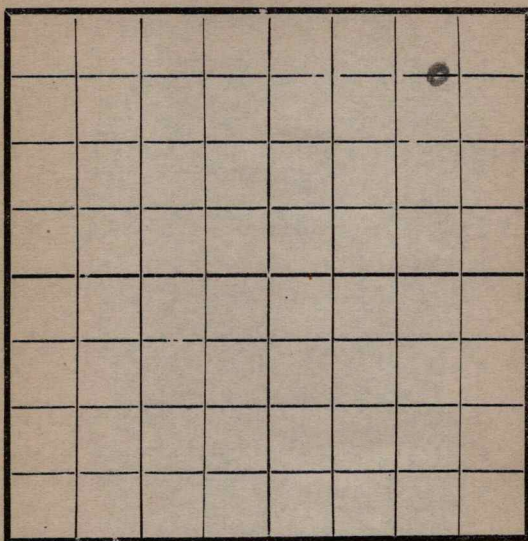

EAST

SOUTH

Location _____

Rig Up _____

Drilling and remarks

Top sand
2435'
Drilling
2473'
hole free oil

RECORD

Cased _____ in. _____ Ft.

Sand _____

Gas _____

Oil _____

Total Depth _____

PRODUCTION

1st 24 hrs. Nat. _____

1st 24 hrs. after shot _____

Gas _____ Cu. Ft.

Dry Hole _____

Abandoned _____


Date

7/6, 191*7* *Sully* Scout

Map No. _____ Sec. 16 Twp. 27 R. 4Well No. 24 Sully Farm _____Prarie Company _____

NORTH

WEST

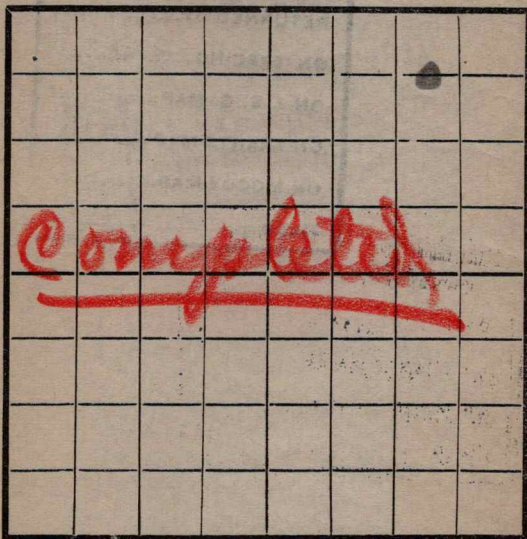

EAST

SOUTH

Location _____

Rig Up _____

Drilling and remarks

Est at
250 Bbls

RECORD

Cased _____ in _____ Ft.

Sand 2435-2525

Gas _____

Oil _____

Total Depth _____

PRODUCTION

1st 24 hrs. Nat. _____

1st 24 hrs. after shot _____

Gas _____ Cu. Ft.

Dry Hole _____

Abandoned _____

Date

7/12, 1917 Candry Scout