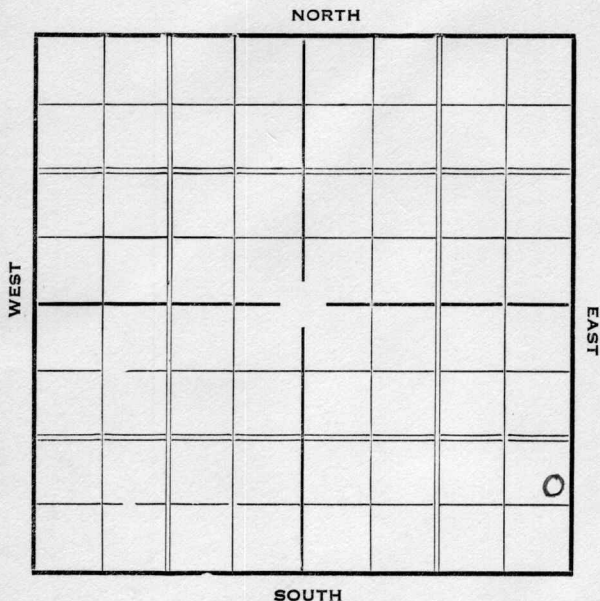


Section 20 Township 23 Range 14-EWell Number 8 PeekCompany Pure Oil

KANSAS

Map No. 17 Sec. 20 Twp. 23 R. 14E

Well No. 8 Peck

Pure Oil Company

Contractor

SECTION PLAT

			0

 Ft. from N. Line

758 Ft. from S. Line

220 Ft. from E. Line

 Ft. from W. Line

FIRST REPORT

Location

Rig up

Drilling and Remarks:

Hack

RECORD

Cased in., ft.

Sand

Gas

Oil

Total Depth

PRODUCTION

1st 24 hrs. Nat.

1st 24 hrs. after shot

Gas Cu. Ft.

Dry Hole

Abandoned

Date

FEB 17 1937 19

S. J. LEWIS

Scout

KANSAS

Woodson

Map No. 17 Sec. 20 Twp. 23 R. 14EWell No. 8 PeekPure Oil Company

Contractor

SECTION PLAT

			o

 Ft. from N. Line258 Ft. from S. Line220 Ft. from E. Line Ft. from W. Line

COMPLETED

Location Rig up

Drilling and Remarks:

Mississippi hole
16603000 acidPotential80 Oil3 water

RECORD

Cased in., ft.Sand Gas Oil Total Depth 1702

PRODUCTION

1st 24 hrs. Nat. 1st 24 hrs. after shot Gas Cu. Ft.Dry Hole Abandoned

Date

MAR 17 1937

19

S. J. LEWIS

Scout