

Woodson

KANSAS

SECTION 20 TOWNSHIP 23 RANGE 14 E

WELL NO. #12 Peak

COMPANY R. L. French

NORTH

WEST									EAST

SOUTH

0

Woodson

KANSAS

SEC.	TWP.	R.
20	23	14E

WELL NO. ¹²
#12 Peak

FARM

COMPANY

R.E. French

CONTRACTOR

Brown

Winterschied


Ft. from N. Line

Ft. from S. Line

Ft. from E. Line

Ft. from W. Line

NE SW SE

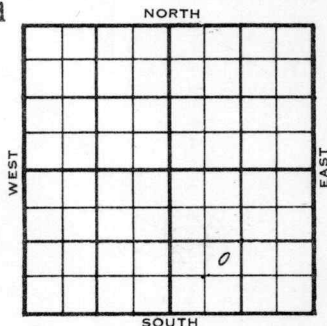

1955

ELEVATION

REPORT

11-23 Comm. 11-21-55
Drlg. 1012-21 8 5/8" @ 830
7" @ 1275
4 1/2" @ 1671
CO to 1689
2000 A
Comp. 5 BOPD
M. 1665
TD 1689'

COMPLETED

County Woodson Elev. _____
 Sec. 20 Twp. 23 Rge. 14E
 Company R. E. French
 Farm Name Peak No. 11

TOPS	DEPTH	LOG	DATUM	Loc. in Sec.
Anh.				NE SW SE
Tp.				
H.				
Tr.				
Dg.				
Bl.				
L.				Geol.
K.C.				Contr.
B.K.C.				Brown
Ce.				Pool
C.				Winterschied
M.				
M.				
K.				
Mz.				
Mo.				
V.				
S.				
S.				
A.				
R.				
Pe.				
G.				
T.D.				

FIRST REPORT
NOV 23 '55

Date Comm. 11-21-55
 drlg. 10

SCOUT TICKET

DX-201

SEC.

20

TWP.

23

R.

14E

WELL NO.

12 Peak

FARM

COMPANY

R. E. French

CONTRACTOR

CORRECTION

NE SW SE

____ FT. FROM N. LINE


990

____ FT. FROM S. LINE

____ FT. FORM E. LINE

990

____ FT. FROM W. LINE

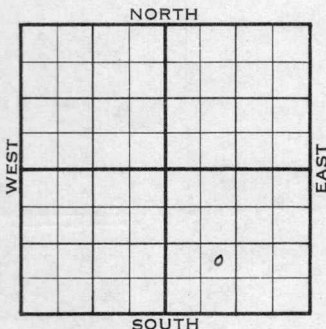

Woodson County

☐

LOCATION

☐

RIG UP

DRILLING AND REMARKS:

Reported

#11 Peak

RECORD

CASED IN., FT.

SAND

GAS

OIL

TOTAL DEPTH

PRODUCTION

1ST 24 HRS. NAT.

1ST 24 HRS. AFTER SHOT

GAS CU. FT.

DRY HOLE

ABANDONED

DATE

DEC 21 1955

SCOUT

County

Woodson

Elev.

Sec.

20

Twp.

23

Rge.

14E

Company

R. E. French

Farm Name

Peak

No.

12

TOPS

DEPTH

LOG

DATUM

Loc. in Sec.

Anh.

Tp.

H.

Tr.

Dg.

B.L.

L.

K.C.

B.K.C.

Ce.

C.

M.

M.

K.

Mz.

Mq.

V.

S.

S.

A.

R.

Pc.

G.

G.

T.D.

NE SW SE

Geol.

Contr.

Brown

Pool

Winterschied

COMPLETE

0

Date Comm. 11-21-55

DEC 21 1955

8 5/8" @ 830/ 7" @ 1275 4 1/2" @ 1671

CO to 1689 2000 A Comp. 5 bopd