

Woodson


Form 51-5M-2-29-34703

Map No. KANSAS Sec. 20 Twp. 23 R. 14

Well No. 1- Schuch Farm

Johnson O.K.S. Company

NORTH

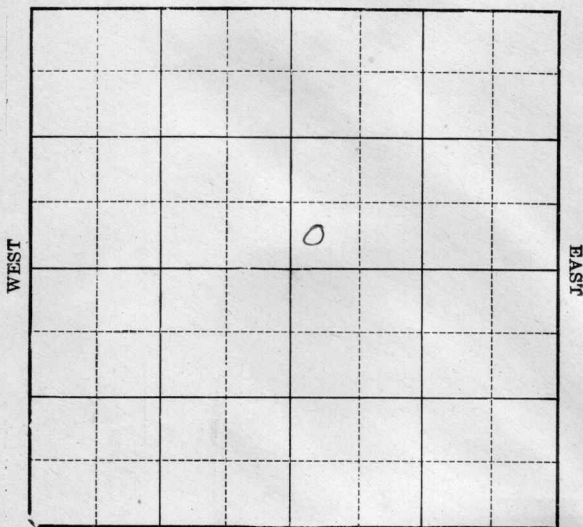

SOUTH

Location

Drilling Remarks

Rig Up

Drilling Remarks

RECORD

Cased in. ft.

Sand

Gas

Oil

Total Depth

PRODUCTION

1st 24 hrs. Nat.

1st 24 hrs. after shot

Gas cu. ft.

Dry Hole

Abandoned

Map No. _____ Sec. *70* Twp. *73* R. *14*

Well No. *1 Schier*

Johnson & Co Company

Contractor

FIRST REPORTS

COMPLETED

_____ Ft. from N. Line

_____ Ft. from S. Line

_____ Ft. from E. Line

_____ Ft. from W. Line

SECTION PLAT

		o	

Location _____

Rig up _____

Drilling and Remarks:

Producer.

RECORD

Cased _____ in., _____ ft.

Sand *1648-1664*

Gas _____

Oil _____

Total Depth *1664*

PRODUCTION

1st 24 hrs. Nat. _____

1st 24 hrs. after shot _____

Gas _____ Cu. Ft.

Dry Hole _____

Abandoned _____

Date

192

Sherwood

Scout