


Greenwood

Map No. *15* Sec. *30* Twp. *24* R. *11*

Well No. *8th Wiggins* Farm
Ward Mc Ginnis Company

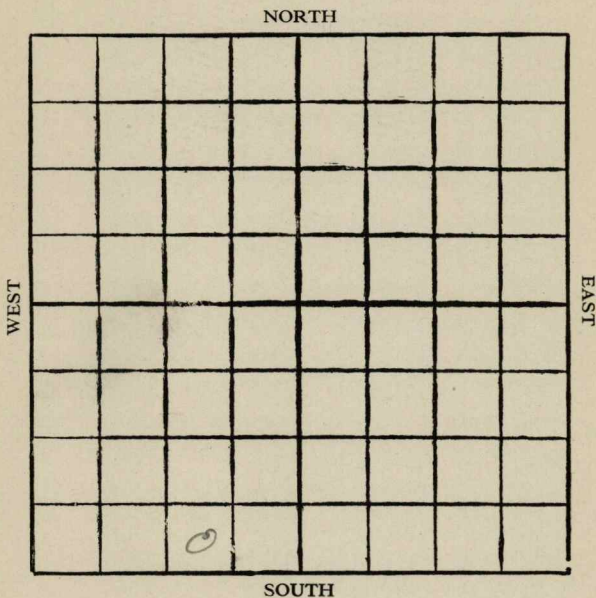

Location

Drilling Remarks

Rig Up

Drilling Remarks

RECORD

Cased in. ft.

Sand

Gas

Oil

Total Depth

PRODUCTION

1st 24 hrs. Nat.

1st 24 hrs. after shot

Gas cu. ft.


Dry Hole

Abandoned

Greenwood

Map No. K5 Sec. 30 Twp. 24 R. 11Well No. P^A Wiggins Farm
Ward-McGinnis company

NORTH

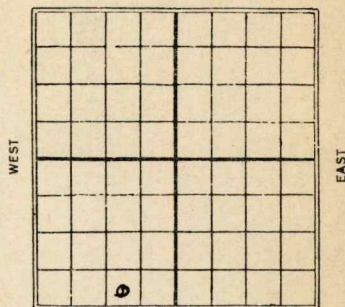

Ft. from N. Line

330 Ft. from S. Line990 Ft. from E. Line

Ft. from W. Line

SOUTH

Date

REPORT

11/23 Rigging up
12/8 Drlg 1350"
12/15 " 1650'
12/22 Sand 1840-1862
60/100 bbls I.D. 1862

16 KANSAS

Map No. _____ Sec. 30 Twp. 24 R. 11

Well No. 8th Wiggins

Ward Mc Ginnis _____ Company

_____ Contractor

FIRST REPORTS

SECTION PLAT

_____ Ft. from N. Line

330 _____ Ft. from S. Line

990 _____ Ft. from E. Line

_____ Ft. from W. Line

	0		

Location _____

Rig up _____

Drilling and Remarks:

Digging up

RECORD

Cased _____ in., _____ ft.

Sand _____

Gas _____

Oil _____

Total Depth _____

PRODUCTION

1st 24 hrs. Nat. _____

1st 24 hrs. after shot _____

Gas _____ Cu. Ft.

Dry Hole _____

Abandoned _____

Date

NOV 23 1926

192

CHAS. L. SHERWOOD

Scout

16 **KANSAS** Sec. 30 Twp. 24 R. 11
 Map No. 8^A Well No. Wiggins
 Ward Mc Sinner Company

Contractor

COMPLETED**SECTION PLAT**

	0		

Ft. from N. Line

330

Ft. from S. Line

990

Ft. from E. Line

Ft. from W. Line

Location

Rig up

Drilling and Remarks:

69 100 lbs.

RECORD

Cased in., ft.

Sand 1840-1862

Gas

Oil

Total Depth 1862

PRODUCTION

1st 24 hrs. Nat.

1st 24 hrs. after shot

Gas Cu. Ft.

Dry Hole

Abandoned

Date

DEC 22 1926

CHAS. I. SHERWOOD

192

Scout