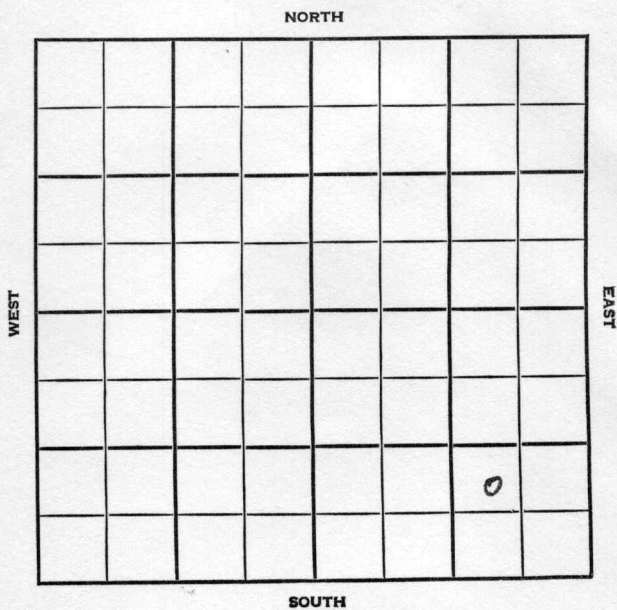


Section 20 Township 23 Range 14EWell No. 10 PeekCompany R. E. French

Woodson

KANSAS

SEC.	TWP.	R.
20	23	14 E

WELL NO.

10 Peek

FARM

COMPANY

R. E. French

CONTRACTOR

Browns

Wintersbheid Pool


Ft. from N. Line

800 Ft. from S. Line

800 Ft. from E. Line

Ft. from W. Line

NW SE SE

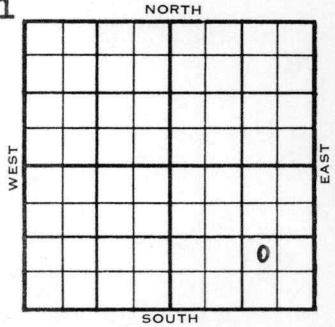

ELEVATION

REPORT

1955

4/20

Spud 4-13-55

Drlg. 6750

County **Woodson** State **Kansas**

Sec. 20 (Blk. Twp.) 23 (Sur. Rge.) 14E Map No.

Operator **R. E. French**

Well No. 10 Farm Peek

[illegible]

0