Miscellanous

FORM 51 10M 8-47


KANSAS

Woodson County O.W.W.O.

Section 20 Township 23 Range 14E

Well No. #2 Schick

Company J. H. Waggoner ~~C. H Barker~~

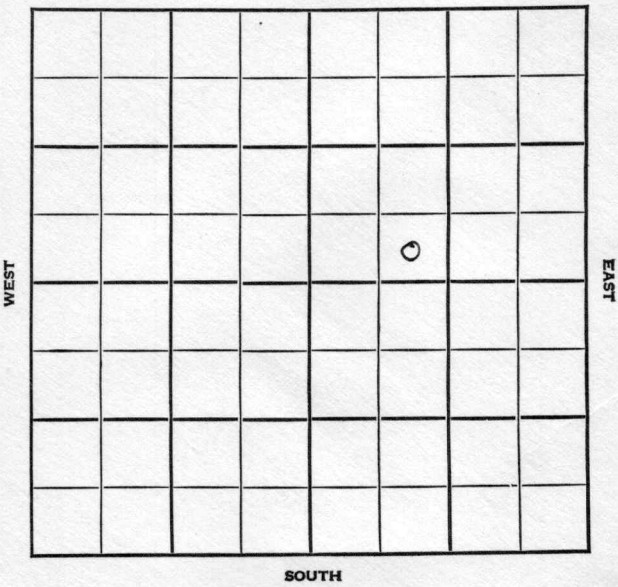

FORM 252-A
5M 9-47 PETROL

O.W.W.O.

KANSAS

Woodson ✓✓

Sec. 20 Twp. 23 R. 14E

Well No. #2 Schick Farm

J. H. Waggoner
~~C. H. Barker~~ Company

Misc. (twin well)

NORTH

WEST

EAST

SOUTH

Ft. from N. Line

330 Ft. from S. Line

Ft. from E. Line

990 Ft. from W. Line

SE SW NE

1947	Elev. - REPORT
12/30	Miss. 1637' 6" @ 1635' TD 1649' 2000 acid. Pump 15 pot.
1948	
1/7	Miss. 1637' 6" @ 1635' 2000 Acid Pump 15 Pot. Gr. 38° Total Depth 1649' COMPLETED
1952	O.W.W.O.
9/24	Spud 9-11-52 10" @ 34' 8" @ 1185' Miss 1616' 5" @ 1627'
10/8	Spud 9-11-52 Oil well TD 1661' 10" @ 34 8" @ 1185 Miss 1631' 5" @ 1631' TD 1661 3000 A Comp. 16 BOPD 60 BW COMPLETED

Form 26 200 Bks. 10-46 Petrol

Kansas

Miscellaneous

Map No. _____ Sec. 20 Twp. 23 R. 14E


Well No. 2 Schick

C. H/ Barker Company

FIRST REPORT Contractor

SE SW NE

SECTION PLAT

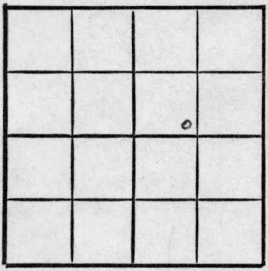

_____ Ft. from N. Line

330 Ft. from S. Line

_____ Ft. from E. Line

990 Ft. from W. Line

Woodson County

Location _____

Rig up _____

Drilling and Remarks:

Miss. 1637

6" @ 1635
TD 1649

2000 acid

Pump 15 pot.

twin well

RECORD

Cased _____ in., _____ ft.

Sand _____

Gas _____

Oil _____

Total Depth _____

PRODUCTION

1st 24 hrs. Nat. _____

1st 24 hrs. after shot _____

Gas _____ Cu. Ft.

Dry Hole _____

Abandoned _____

Date

DEC 3 0 1947 19

S. J. LEWIS Scout

Form 26 200 Bks. 10-46 Petrol

Kansas

Miscellaneous

Map No. 17 Sec. 20 Twp. 23 R. 14E

Well No. 2 Schick


C. H. Barker Company

COMPLETE

Contractor

SE SW NE

SECTION PLAT

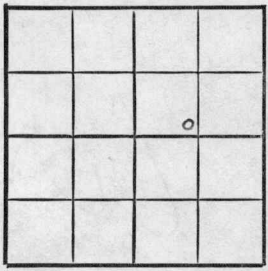

____ Ft. from N. Line

330 Ft. from S. Line

____ Ft. from E. Line

990 Ft. from W. Line

Woodson County

Location

Rig up

Drilling and Remarks:

Miss 1687

6 "C" 1635

2000 Acid

Pump 15 Bbl

88 Gr

RECORD

Cased ____ in., ____ ft.

Sand

Gas

Oil

Total Depth 1649

PRODUCTION

1st 24 hrs. Nat.

1st 24 hrs. after shot

Gas ____ Cu. Ft.

Dry Hole

Abandoned

Date

JAN 7 1948 19

S. J. LEWIS Scout

FORM 275 FOR SALE BY KANSAS BLUE PRINT CO.

O.W.W.O.


County Woodson State Kansas

Sec. 20 (Blk. Twp.) 23 (Sur. Rge.) 14E Map No.

Operator J. H. Waggnor

Well No. 2 Farm Schick

Elev. Location SE SW NE

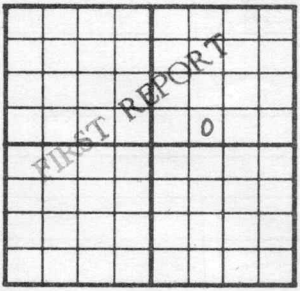

330 Ft. From S Line NE

990 Ft. From W Line Quarter

1st. Report SEP 24 1952

Completion

Remarks

Waggnor - Contr.

Spudding Date 9-11-52

Drlg. Data

10" @ 34 8" @ 1185 Miss. 1616

5" @ 1627

J. G. McGEHEE

FORM 275 FOR SALE BY KANSAS BLUE PRINT CO.


County Woodson State Kansas

Sec. 20 (Blk. Twp.) 23 (Sur. Rge.) 14E Map No.

Operator J. H. Waggnor

Well No. 2 Farm Schick

Elev. Location SE SW NE

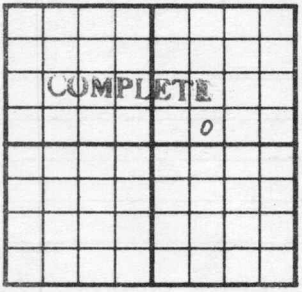

330 Ft. From S Line NE

990 Ft. From W Line Quarter

1st. Report

Completion OCT 8 1952

Remarks

Waggnor - Contr.

Spudding Date 9-11-52

Drlg. Data Oil well TD 1661

10" @ 34 8" @ 1185 Miss. 1631

5" @ 1631 TD 1661 3000 A

Comp. 16 bopd 60 bw

J. G. McGEHEE