


Section 7 Township 24 Range 10E

Well No. 2 Burke "B"

Company Ward McGinnis

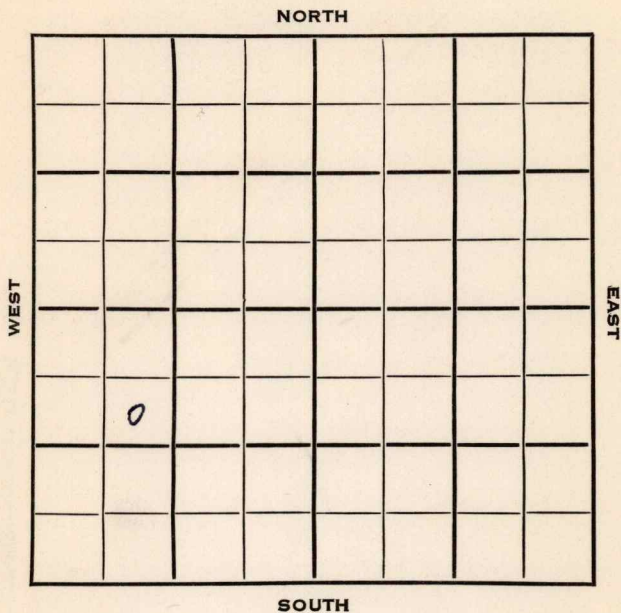

Greenwood

KANSAS

SEC.

TWP.

R.

7

24

10 E

WELL NO.

2 Burke "B"

FARM

COMPANY

Ward McGinnis

CONTRACTOR

Ward McGinnis

Thrall-Agard Pool

990

Ft. from N. Line


Ft. from S. Line

Ft. from E. Line

990

Ft. from W. Line

SE NW SW

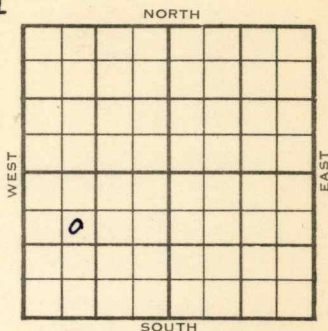

1953

ELEVATION

REPORT

12/16

LXX Spud 12-15-53

1254

1/13

Spud 12-15-53 Oil well TD 2197'
6" @ 100 **Bart 2184'** TD 2197'
4" @ 2185 CO to 2196 SSO
Hydro.
Comp. 24 BOPD

COMPLETED

County Greenwood State Kansas
 Sec. 7 (Blk.) 24 (Sur.) 10E Map No.
 Operator Ward McGinnis
 Well No. 2 Farm Burke "B"
 Elev. Location SE NW SW



990 Ft. From N Line SW
990 Ft. From W Line Quarter

1st. Report

Completion JAN 13 1954

Remarks Thrall-Agard Pool

Ward McGinnis - Contr.

Spudding Date 12-15-53

Drlg. Data Oil well TD 2197

6" @ 100 Bart. 2184 TD 2197

4" @ 2185 CO to 2196 SSO Hydro.

Comp. 24 bopd

J. G. McGEHEE