


Section 7 Township 24 Range 10 E

Well No. # 2 Oldham

Company Ward McGinnis

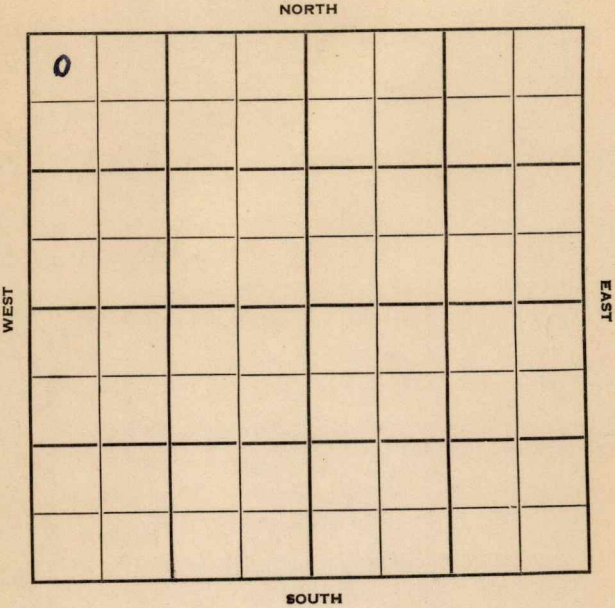

Sec. 7 Twp. 24 R. 10E

Well No. #2 Oldham Farm

Ward McGinnis Company

Contractor


330 Ft. from N. Line

Ft. from S. Line

Ft. from E. Line

330 Ft. from W. Line

NW NW NW

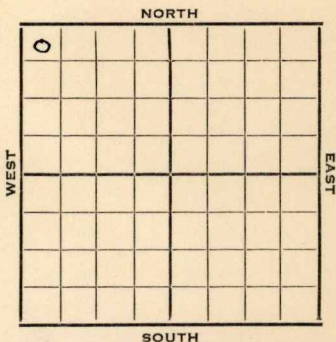

1952

Elev. -

REPORT

5/21

Cored 2070'

7/2

Water input well. TD 2243'

Bart. 2210' 5" @ 2211 TD 2243'

3/4 BWPH PB 2238' 13 qt. 12 BO
13 BW

Comp. water input well

ABANDONED

County **Greenwood** State **Kansas**
 Sec. **7** (Blk.) **24** (Sur.) **10E** Map No.

Operator **Ward McGinnis**

Well No. **2** Farm **Oldham**

Elev. Location **NW NW NW**

a							

330 Ft. From **N** Line **NW**

330 Ft. From **W** Line Quarter

1st. Report **MAY 21 1952**

Completion

Remarks

Spudding Date

Drlg. Data

Cored 2070

J. G. McGEHEE

County Greenwood State Kansas
 Sec. 7 (Blk.) 24 (Sur.) 10E Map No.
 Operator Ward McGinnis
 Well No. 2 Farm Oldham
 Elev. _____ Location NW NW NW

0					

330 Ft. From N Line NW
330 Ft. From W Line Quarter

1st. Report _____

Completion JUL 2 1952

Remarks _____

Spudding Date _____

Drlg. Data Water input well TD 2243
Bart. 2210 5" @ 2211 TD 2243
3/4 bwph PB 2238 13 qt 12 bo 13 bw
Comp. water input well

J. G. McGEHEE