


Hoodson

Form 51-5M-2-29-34703

Map No. **KANSAS** Sec. 21 Twp. 23 R. 14

Well No. 1- Otto Farm
Hillside Oil Co Company

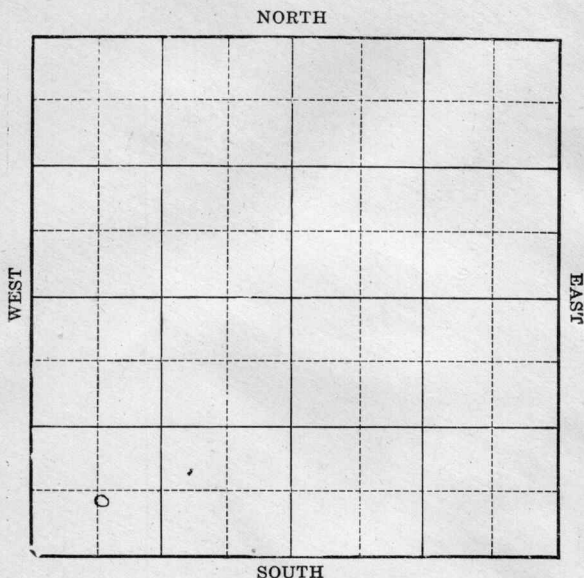

Location _____
Drilling Remarks _____

Rig Up _____
Drilling Remarks _____

RECORD

Cased _____ in. _____ ft.
Sand _____
Gas _____
Oil _____
Total Depth _____

PRODUCTION

1st 24 hrs. Nat. _____
1st 24 hrs. after shot _____
Gas _____ cu. ft.
Dry Hole _____
Abandoned _____

Woodson

Map No. _____ Sec. 27 Twp. 23 R. 14Well No. 1 OttoHillside Oil Co Company

Contractor

FIRST REPORTS
COMPLETED

SECTION PLAT

0			

_____ Ft. from N. Line

600 Ft. from S. Line

_____ Ft. from E. Line

670 Ft. from W. Line

Location _____

Rig up _____

Drilling and Remarks:

407 vs Bls.

RECORD

Cased _____ in., _____ ft.

Sand 1600-1722

Gas _____

Oil _____

Total Depth 1722

PRODUCTION

1st 24 hrs. Nat. _____

1st 24 hrs. after shot _____

Gas _____ Cu. Ft.

Dry Hole _____

Abandoned _____

Date

3/1/27 192Sherwood Scout