


Woodson
Form 51-5M-2-29-34703
Map No. KANSAS Sec. 21 Twp. 23 R. 14
Well No. 2 - Otto Brothers Oil Co. Farm Company

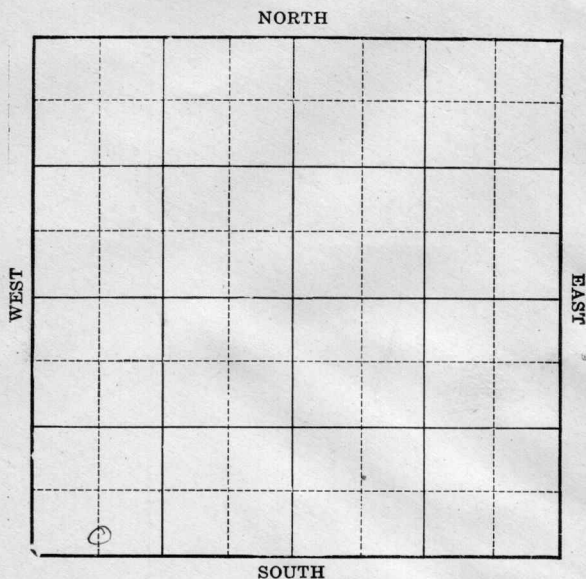

Location _____
Drilling Remarks _____

RECORD

Cased _____ in. _____ ft.
Sand _____
Gas _____
Oil _____
Total Depth _____

Rig Up _____
Drilling Remarks _____

PRODUCTION

1st 24 hrs. Nat. _____
1st 24 hrs. after shot _____
Gas _____ cu. ft.
Dry Hole _____
Abandoned _____

Woodson

Map No. _____ Sec. 21 Twp. 23 R. 14Well No. 2 AttoBrothers Oil Co Company

Contractor

FIRST REPORTS

COMPLETED

_____ Ft. from N. Line

200 Ft. from S. Line

_____ Ft. from E. Line

760 Ft. from W. Line

SECTION PLAT

Location _____

Rig up _____

Drilling and Remarks:

Tap line 167040730 Bls.

RECORD

Cased _____ in., _____ ft.

Sand 1670-1702

Gas _____

Oil _____

Total Depth 1702

PRODUCTION

1st 24 hrs. Nat. _____

1st 24 hrs. after shot _____

Gas _____ Cu. Ft.

Dry Hole _____

Abandoned _____

Date

2/4/21 192Sherwood Scout