

Woodson

KANSAS

SECTION 21 TOWNSHIP 23 RANGE 14 E

WELL NO. ~~#8~~ ² Otto

COMPANY R. E. French

NORTH

WEST

0							

EAST

SOUTH

Woodson

KANSAS

SEC.	21	TWP.	23	R.	14E
------	----	------	----	----	-----

WELL NO. #2
~~AS~~ Otto

FARM

COMPANY

R. E. French

CONTRACTOR

Vern Brown

Winterscheid


Ft. from N. Line

Ft. from S. Line

Ft. from E. Line

Ft. from W. Line

SW SW NW

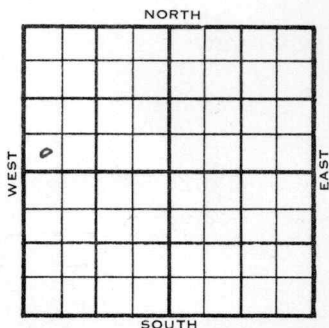

1955

ELEVATION

REPORT

10/19

Comm 10-10-55

10" @ 60

Dr1g 1080

11-16

8" @ 1110

4" @ 1625

CO to 1656

2000 A

Comp. 6 bopd

TD 1656'

Tops: M. lime 1625'

COMPLETED

County Woodson Elev. _____
 Sec. 21 Twp. 23 Rge. 14E
 Company R. E. French
 Farm Name Otto No. 8

TOPS	DEPTH	LOG	DATUM	Loc. in Sec.
Anh.				SW SW NW
Tr.				
H.				
Tr.				
Dg.				
B.L.				
L.				Geol. _____
K.C.				Contr. _____
B.K.C.				Vern Brown
Ce.				
C.				Pool _____
M.				Winterscheid
M.				
K.				
Mz.				
Ma.				
V.				
S.				
S.				
A.				
R.				
Pe.				
G.				
T.D.				

OCT 19 1955	
FIRST REPORT	

Date Comm. 10-10-55
10" @ 60 d rlg. 1080

Co.

Lse.

No.

Sec.

T.

R.

SCOUT TICKET

DX-201

SEC.

21

TWP.

23

R.

11E

WELL NO.

2 Otto

FARM

COMPANY

R. E. French

CONTRACTOR

CORRECTION

SW SW NW

FT. FROM N. LINE

330


FT. FROM S. LINE

FT. FORM E. LINE

330

FT. FROM W. LINE

NORTH

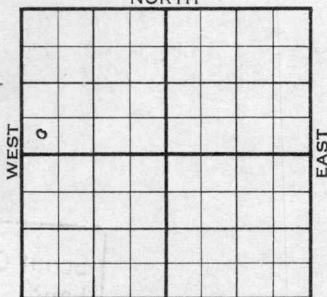

SOUTH

Woodson County

☐

LOCATION

☐

RIG UP

DRILLING AND REMARKS:

Reported
#8 Otto

RECORD

CASED IN., FT.

SAND

GAS

OIL

TOTAL DEPTH

PRODUCTION

1ST 24 HRS. NAT.

1ST 24 HRS. AFTER SHOT

GAS CU. FT.

DRY HOLE

ABANDONED

DATE

SCOUT

NOV 16 1955

County Woodson Elev. _____
 Sec. 21 Twp. 23 Rge. 14E
 Company R. E. French
 Farm Name Otto No. 2

TOPS	DEPTH	LOG	DATUM	Loc. in Sec.
Anh.				SW SW NW
Tr.				
H.				
Tr.				
Dg.				
BL.				
L.				Geol.
K.C.				Contr.
B.K.C.				Vern Brown
Ce.				Pool
C.				Winterscheid
M.				
M. <i>(lime)</i>	<i>1625</i>			
K.				
Mz.				
Mq.				
V.				
S.				
S.				
A.				
R.				
PE.				
G.				
T.D.	<i>1656</i>			

Date Comm. 10-10-55 NOV 9 1955

10" @ 60 8" @ 1110 4" @ 1625

CO to 1656 2000 A Comp. 6 bopd

COMPLETE

First reported as #8 Otto
Completed as #2.

Please advise.

Mickey
Scouting

NOV 25 1955

Scout Cards	<i>SL</i>
Land Small Map	
Land Wall Map	
Tracings	
France Map	
Pierce Map	
Misc.	