


Section 21 Township 23 Range 14 E

Well No. # 1 Otto

Company Throgmarten & French

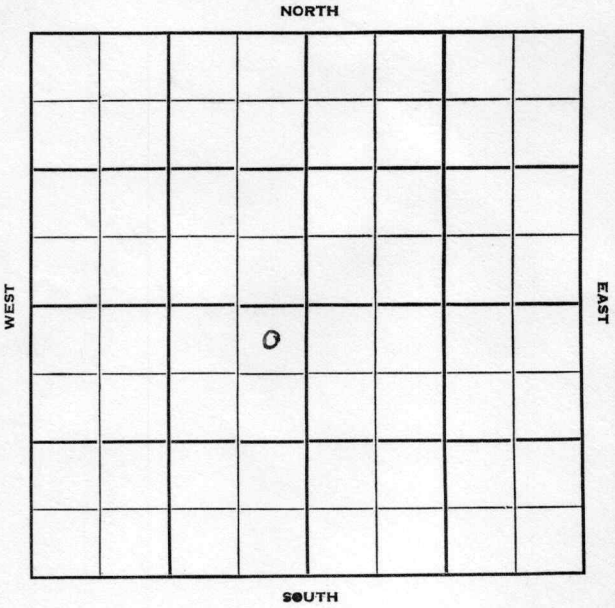

Woodson

KANSAS

Sec. 21 Twp. 23 R. 14E ✓

Well No. #1 Otto Farm

Throgmarten & French Company

Brown Contractor


330 Ft. from N. Line

_____ Ft. from S. Line

330 Ft. from E. Line

_____ Ft. from W. Line

NE NE SW

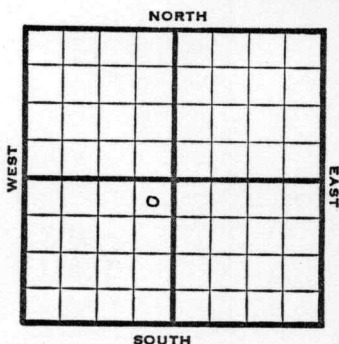

1952

Elev. -

REPORT

2/13 RUR C.T.

3/26 Spud 2-14-52

Oil well TD 1685' 10" @ 750

Miss 1662' 5" @ 1672' TD 1685'

2000 A

Comp. 15 BOPD

COMPLETED

County Woodson State Kansas

Sec.	21	(Blk. Twp.)	23	(Sur. Rge.)	14E	Map No.
------	----	----------------	----	----------------	-----	---------

Operator Throgmarten & French

Well No. 1 Farm Otto

Elev.	Location	NE	NE	SW

330 Ft. From N Line SW

330 Ft. From E Line Quarter

1st. Report

Completion MAR 26 1954

Remarks

Brown - Contr.

Spudding Date 2-14-52

Drilg. Data Oil well TD 1685

10" @ 750 Miss. 1662 5" @ 1672

TD 1685 2000 A Comp. 15 bopd