


Greenwood ✓

Map No. *17N* Sec. *25* Twp. *24* R. *10*

Well No. *4* *Nixon* Farm

Phillips Pet. Company

NORTH

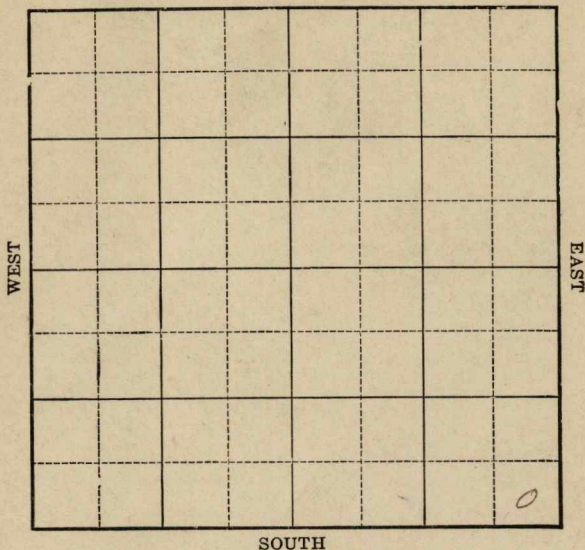

Location _____

Drilling Remarks _____

Rig Up _____

Drilling Remarks _____

RECORD

Cased _____ in. _____ ft.

Sand _____

Gas _____

Oil _____

Total Depth _____

PRODUCTION

1st 24 hrs. Nat. _____

1st 24 hrs. after shot _____

Gas _____ cu. ft.


Dry Hole _____

Abandoned _____

Greenwood

Map No. 19N Sec. 25 Twp. 24 R. 10Well No. 4 Nixon Farm
Phillips Petroleum Company

NORTH

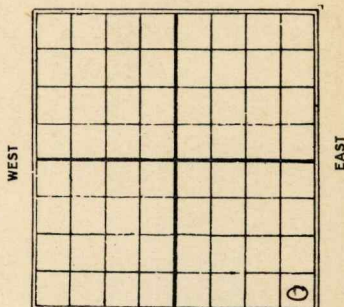

Ft. from N. Line

330 Ft. from S. Line330 Ft. from E. Line

Ft. from W. Line

SOUTH

1926

Date

REPORT

8/4 Location

8/11 Bldg rig

8/18 rigging up

8/25 same

8/31 only 960'

9/15 top sd 1828, oil 1844
bottom sd 1827

T.D. 1828, will shoot

9/22 Sand 1828-1827

75/75 bbls

16 **KANSAS** 25 Twp. 24 R. 10
 Map No. Sec. Twp. R.

Well No. 4
 Philip Let 8
 Company

Contractor

FIRST REPORTS

SECTION PLAT

Ft. from N. Line

230 Ft. from S. Line

230 Ft. from E. Line

Ft. from W. Line

Location ✓

Rig up

Drilling and Remarks:

RECORD

Cased _____ in., _____ ft.

Sand _____

Gas _____

Oil _____

Total Depth _____

PRODUCTION

1st 24 hrs. Nat. _____

1st 24 hrs. after shot _____

Gas _____ Cu. Ft.

Dry Hole _____

Abandoned _____

Date

AUG 4 1926

CHAS. L. SHERWOOD

192

Scout

16 **KANSAS** Sec. 25 Twp. 24 R. 10

Well No. 4 Myon
Phillips Pet Co Company

Contractor

COMPLETED

SECTION PLAT

----- Ft. from N. Line

330 ----- Ft. from S. Line

330 ----- Ft. from E. Line

----- Ft. from W. Line

			0

Location -----

Rig up -----

Drilling and Remarks:

75/75 BS.

RECORD

Cased ----- in., ----- ft.

Sand 1828-1857

Gas -----

Oil -----

Total Depth 1858

PRODUCTION

1st 24 hrs. Nat. -----

1st 24 hrs. after shot -----

Gas ----- Cu. Ft.

Dry Hole -----

Abandoned -----

Date

SEP 22 1926

CHAS. L. SHERWOOD

192

Scout