


Section 21 Township 23 Range 14E

Well No. 3 Otto

Company Throgmorton

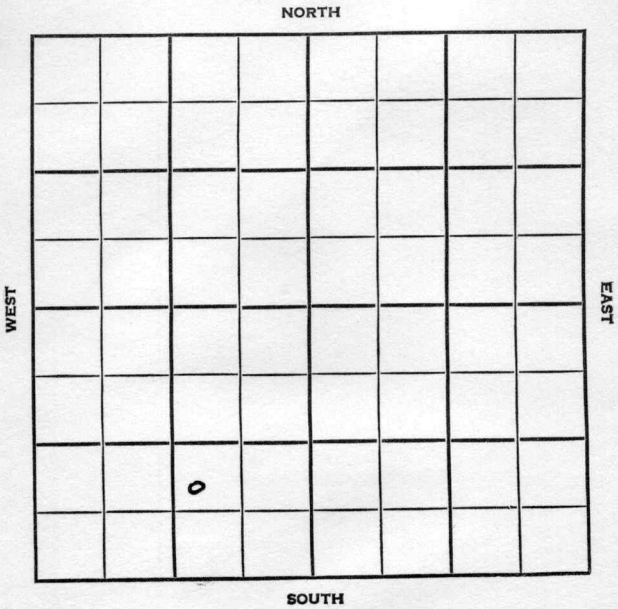

SEC. 21	TWP. 23	R. 14E ✓
-------------------	-------------------	--------------------

WELL NO.

3 Otto FARM

COMPANY

Throgmorton

CONTRACTOR

Brown

Wintersheid Pool

Ft. from N. Line


1000

Ft. from S. Line

Ft. from E. Line

1600

Ft. from W. Line

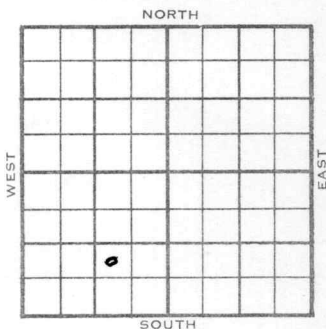

NW SE SW

1954

ELEVATION

REPORT

6/9

Rust

8 5/8" @ 831

Miss. 1649

5 1/2" @ 1655

TD 1664 1000 A POP

6/23

Spud 5-19-54 Oil well TD 1664

8" @ 831 Miss 1649 5" @ 1655

TD 1664 1000 A

Comp. 35 BOPD

COMPLETED

County **Woodson** State **Kansas**

Sec. **21** (Blk. Twp.) **23** (Sur. Rge.) **14E** Map No.

Operator Throgmorton

Well No. 3 Farm Otto

Elev.	Location	NW	SE	SW
-------	----------	----	----	----

[illegible]

1000 Ft. From S Line SW

1600 Ft. From W Line Quarter

1st. Report **JUN 9 1954**

Completion

Remarks

Brown - Contr.

Spudding Date 5-19-54

Drlg. Data Wintersheid Pool

RUST 8 5/8" @ 831 Miss. 1649

5 $\frac{1}{2}$ " @ 1655 TD 1664 1000 A POP

J. G. McGEHEE

County Woodson State Kansas
 Sec. 21 (Blk.) 23 (Sur.) 14E Map No.
 Operator Throgmorton
 Well No. 3 Farm Otto
 Elev. _____ Location NW SE SW



1000 Ft. From S Line SW
1600 Ft. From W Line Quarter
 1st. Report _____
 Completion JUN 23 1954
 Remarks Wintersheid Pool
Brown - Contr.
 Spudding Date 5-19-54

Drlg. Data Oil well TD 1664

8" @ 831 Miss. 1649 5" @ 1655

TD 1664 1000 A Comp. 35 bopd