


Map No. _____ Sec. 21 Twp. 27 R. 4
 Well No. 27 Farm _____
Memm Company _____

NORTH

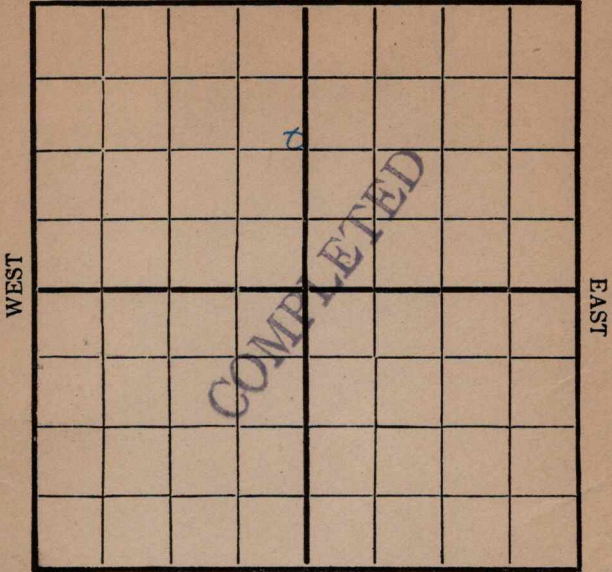

SOUTH

Location _____

Drilling Remarks

8/30 , 1425

Rig Up _____

Drilling Remarks

RECORD

Cased _____ in. _____ Ft.

Sand 2362-94

Gas _____

Oil _____

Total Depth _____

PRODUCTION

1st 24 hrs. Nat. 600 1800

1st 24 hrs. after shot _____


Gas _____ Cu. Ft.

Dry Hole _____

Abandoned _____

Map No. _____ Sec. 21 Twp. 27 R. 4
 Well No. 2 D. coal Farm _____
McMan Company _____

NORTH

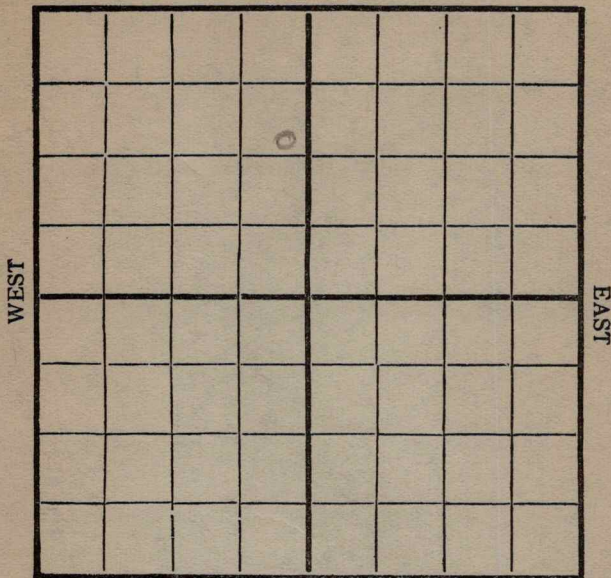

SOUTH

Location _____
 Rig Up _____
 Drilling and remarks _____

1425

RECORD

Cased _____ in. _____ Ft.
 Sand _____
 Gas _____
 Oil _____
 Total Depth _____

PRODUCTION

1st 24 hrs. Nat. _____
 First 24 h.s. after shot _____
 Gas _____ Cu. Ft.
 Dry Hole _____
 Abandoned _____

Date _____ 191____ Scout McMan


AUG 30 1916

Map No. _____ Sec. 21 Twp. 22 R. 4
 Well No. 2 Deal Farm _____
McKee Company _____

NORTH

WEST

EAST

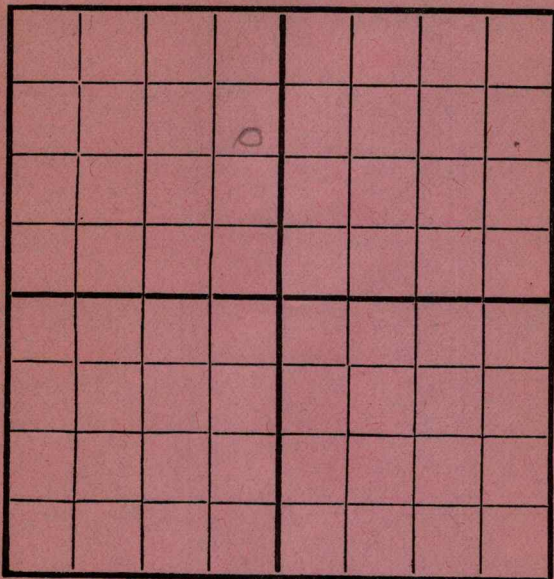

SOUTH

Location _____

Rig Up _____

Drilling and remarks

2122

RECORD

Cased _____ in. _____ Ft.

Sand _____

Gas _____

Oil _____

Total Depth _____

PRODUCTION

1st 24 hrs. Nat. _____

1st 24 hrs. after shot _____

Gas _____ Cu. Ft.

Dry Hole _____

Abandoned _____


Date

9/12, 1916 Robert D. P. Scout

Map No. _____ Sec. 21 Twp. 27 R. 4
 Well No. 3 Deer Farm _____
manish Company _____

NORTH

WEST

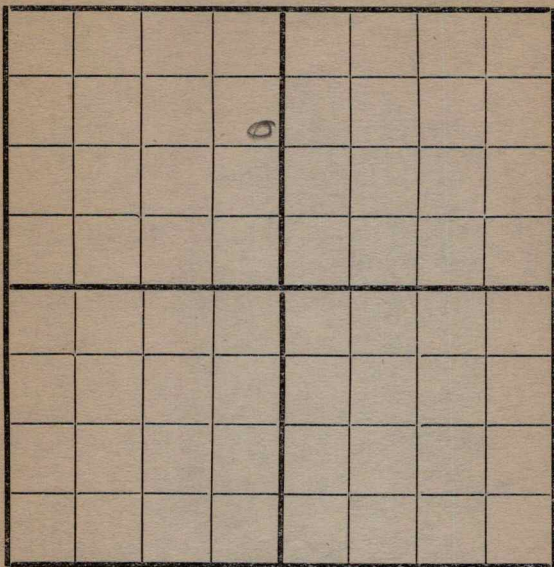

EAST

SOUTH

Location _____

Rig Up _____

Drilling and remarks

At top sand

RECORD

Cased _____ in. _____ Ft.

Sand 2362

Gas _____

Oil _____

Total Depth _____

PRODUCTION

1st 24 hrs. Nat. _____

1st 24 hrs. after shot _____

Gas _____ Cu. Ft.

Dry Hole _____


Abandoned _____

Date

9/20, 1916 Scout

Map No. _____ Sec. 21 Twp. 27 R. 4
 Well No. 2 Deep Farm _____
W. W. W. Company _____

NORTH

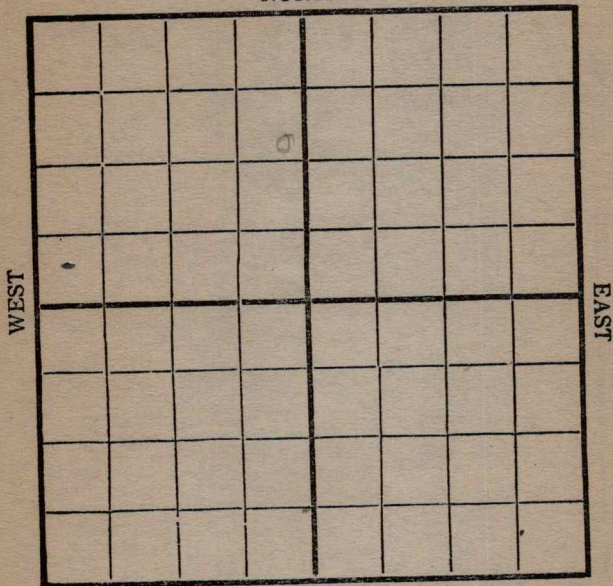

SOUTH

RECORD

Location _____ Cased _____ in. _____ Ft.
 Rig Up _____ Sand _____
 Drilling and remarks _____ Gas _____
 _____ Oil _____
 _____ Total Depth _____

PRODUCTION

1st 24 hrs. Nat. _____
 First 24 hrs. after shot _____
 Gas _____ Cu. Ft. _____
 Dry Hole _____
 Abandoned _____

Date

7/25, 1915 C. R. R. Scout _____

