


Section 21 Township 23 Range 11 E

Well No. # 7 Otto

Company R. E. French

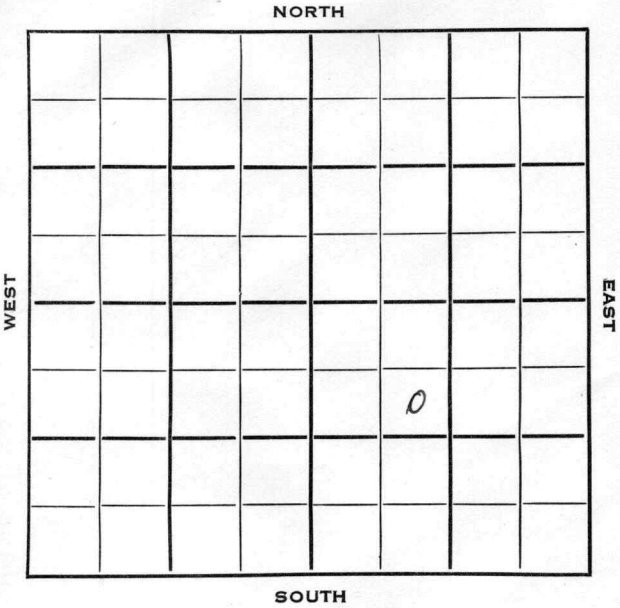

Woodson

KANSAS

SEC.	TWP.	R.
21	23	14 E ✓

WELL NO.

7 Otto

FARM

COMPANY

R. E. French

CONTRACTOR


990 Ft. from N. Line

Ft. from S. Line

Ft. from E. Line

990 Ft. from W. Line

SE NW SE

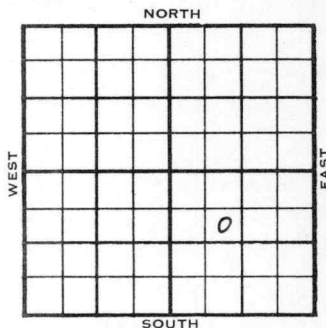

ELEVATION

REPORT

1954

4/7 Spud 3-30-54
Drlg. 770'

4/21 Spud 3-30-54 Oil well TD 1676
8" @ 820 7" @ 1270 5" @ 1661
Miss. chert 1654 TD 1676 2000 A
Comp. 25 BOPD

COMPLETED

County Woodson State Kansas
 Sec. 21 (Blk. 23 (Sur. 14E Map No.
 (Twp.) (Rge.)
 Operator R. E. French
 Well No. 7 Farm Otto
 Elev. Location SE NW SE


FIRST REPORT

990 Ft. From N Line SE
990 Ft. From W Line Quarter
 1st. Report APH 7 1954
 Completion
 Remarks
 Spudding Date 3-30-54

Drlg. Data

drlg. 770

J. G. McGEHEE

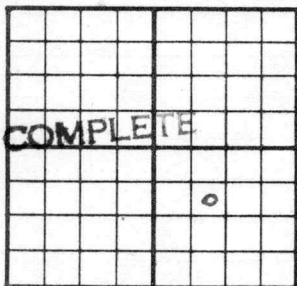County Woodson State KansasSec. 21 (Blk.
Twp.) 23 (Sur.
Rge.) 14E Map No.Operator R. E. FrenchWell No. 7 Farm OttoElev. Location SE NW SE990 Ft. From N Line SE990 Ft. From W Line Quarter1st. ReportCompletion APR 21 1954RemarksSpudding Date 3-30-54Drlg. Data Oil well TD 16768" @ 820 7" @ 1270 5" @ 1661Miss. chert 1654 TD 1676 2000 AComp. 25 bopd