


Section 21 Township 23 Range 14E

Well No. #5 Otto

Company R.E. French

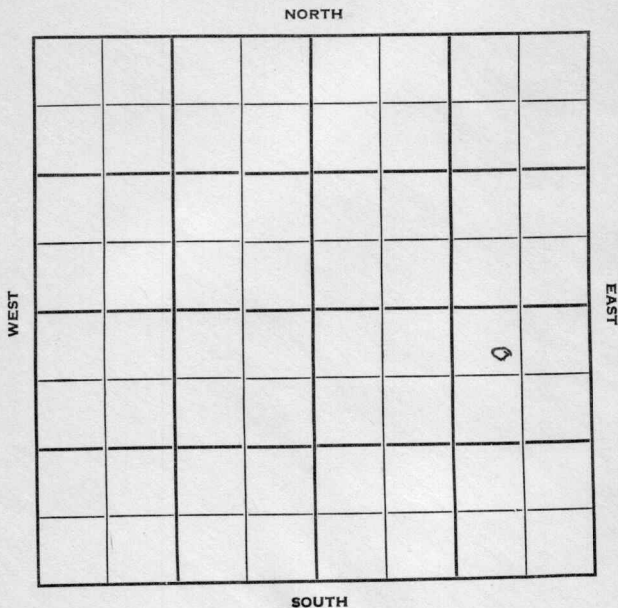

Woodson

KANSAS

Sec. 21 Twp. 23 R. 14E

Well No. #5 Otto Farm

R. E. French Company

Contractor


400 Ft. from N. Line

Ft. from S. Line

1000 Ft. from E. Line

Ft. from W. Line

SE $\frac{1}{4}$ NW NE SE

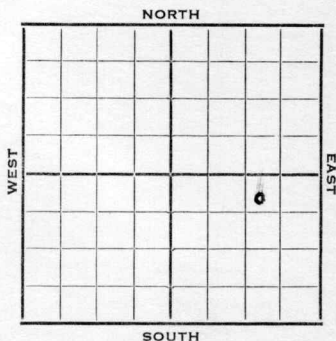

1952 Elev. - REPORT

10/22

Spud 10-13-52
8" @ 835'
Drlg. 920'

11/12

Spud 10-13-52
Oil Well
TD 1684'
8" @ 835
Miss 1649
TD 1674
5" @ 1658
DD 1684 7 bopd 2000A
Comp. 15 bopd

COMPLETED

County Woodson State KansasSec. 21 (Blk.
Twp.) 23 (Sur.
Rge.) 14E Map No.Operator R. E. FrenchWell No. 5 Farm OttoElev. Location NW NE SE

400 Ft. From N Line SE1000 Ft. From E Line Quarter1st. Report OCT 22 1952

Completion

Remarks

Spudding Date 10-13-52

Drlg. Data

8" @ 835 drlg. 920

J. G. McGEHEE

County Woodson State Kansas
 Sec. 21 (Blk. 23 (Sur. 14E Map No.

Operator R. E. French

Well No. 5 Farm Otto

Elev. Location NW NE SE

COMPLETE

400 Ft. From N Line SE
1000 Ft. From E Line Quarter

1st. Report

Completion NOV 12 1952

Remarks

Spudding Date 10-13-52

Drlg. Data Oil well TD 1684

8" @ 835 Miss. 1649 TD 1674

5" @ 1658 DD 1684 7 bopd 2000 A

Comp. 15 bopd

J. G. McGEHEE