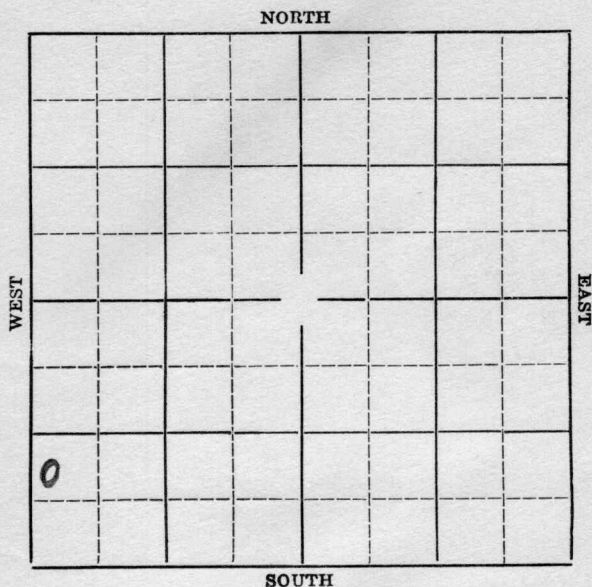


Section 21 Township 23 Range 14EWell Number #5 OttoCompany Quartet Oil

Map No. KANSAS Sec. 21 Twp. 23 R. 14E

Well No. #5 Ott Farm


Quartet Oil. Company

 Ft. from N. Line

758' Ft. from S. Line

 Ft. from E. Line

220' Ft. from W. Line

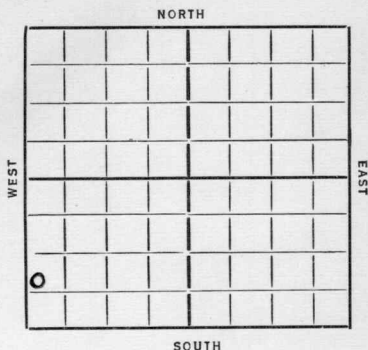

Date
1936

REPORT

6/3 Rigging up.

6/11 Drig. 690'.

7/1/36-Miss. 1661'.

Pay 1680-88'.

3000 gallons of acid.

T.D. 1700'.

15 bbls of oil.

COMPLETED

KANSASMap No. 17 Sec. 21 Twp. 23 R. 14EWell No. 5 OttQuartet Oil Company

Contractor

SECTION PLAT

 Ft. from N. Line758 Ft. from S. Line Ft. from E. Line220 Ft. from W. Line**FIRST REPORT**Location Rig up

Drilling and Remarks:


*Rigging up.***RECORD**Cased in., ft.Sand Gas Oil Total Depth **PRODUCTION**1st 24 hrs. Nat. 1st 24 hrs. after shot Gas Cu. Ft.Dry Hole Abandoned

Date

JUN 3 1936 19S. J. LEWIS Scout

Sam. Our tracing shows a #2
well at approximately this
same Loc. Have scout
check and see if this is a
Twin. Thanks.

Pittman.

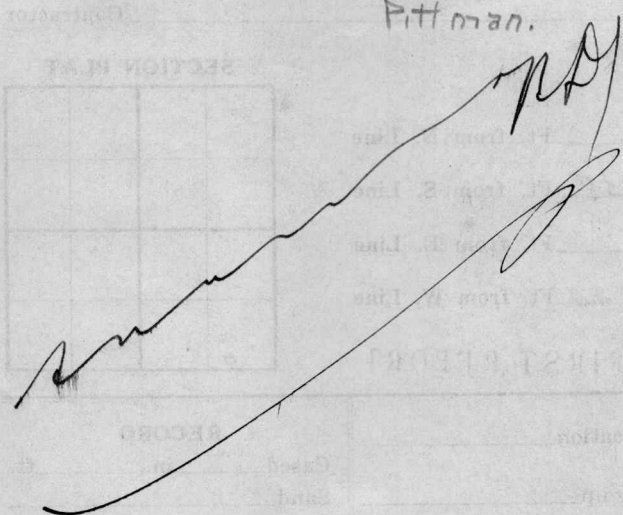

Returned	<i>Sh.</i>
Cards	
Tracing	<i>Joe</i>
France Map	<i>[initials]</i>
Scarborough Map	<i>[initials]</i>
Moody Map	<i>[initials]</i>
Scarborough Plat Book	
Moody Plat Book	

KANSAS

Map No. 17 Sec. 21 Twp. 23 R. 14EWell No. 50 ftQuartet Oil Company

Contractor

SECTION PLAT

0			

 Ft. from N. Line758 Ft. from S. Line Ft. from E. Line220 Ft. from W. Line

COMPLETED

Location Rig up

Drilling and Remarks:

Miss 1661
Pay 1680-88
8000 acid
1588 k

RECORD

Cased in., ft.Sand Gas Oil Total Depth 1700

PRODUCTION

1st 24 hrs. Nat. 1st 24 hrs. after shot Gas Cu. Ft.Dry Hole Abandoned

Date

JUL 1 1936 19

S. J. LEWIS Scout