


DX 78-1 Woodson

KANSAS

Section 21 Township 23 Range 14E

Well No. #6 Otto

Company A. W. Throckmorton

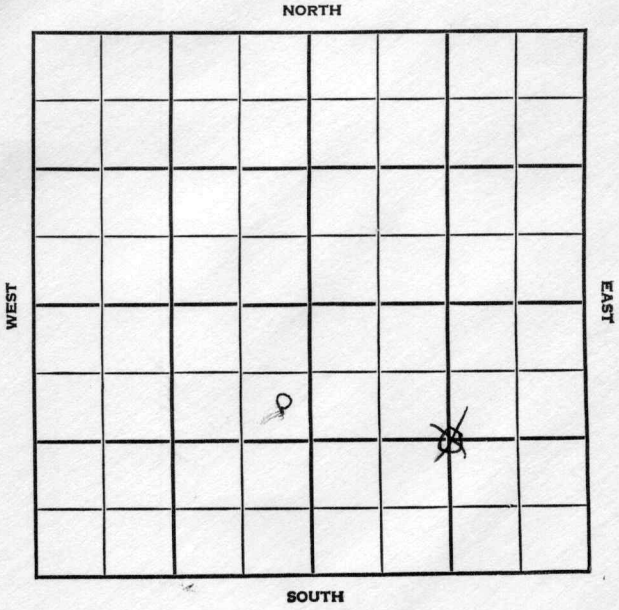

SEC.	TWP.	R.
21	23	14E

WELL NO.

6 Otto

FARM

COMPANY

A. W. Throckmorton

CONTRACTOR

E. Sauder

Wintershied Pool

Ft. from N. Line


1320 1600 Ft. from S. Line

1320 Ft. from E. Line

1600 Ft. from W. Line

C SE 1/4

SW NE SW

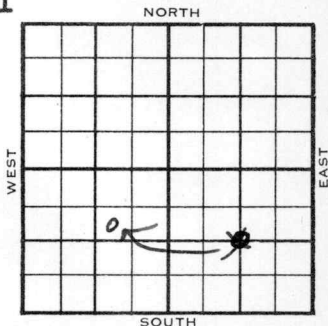

1954

ELEVATION
1148'

REPORT

10/27

Location

12/1

Spud 10-25-54

Oil Well

TD 1672'

8" @ 818'

Miss Chat. 1645' Miss Lm 1647'

TD 1672'

4 1/2" @ 1653'

2000 A

P/ 40 bopd.

Comp 15 bopd.

COMPLETED

County Woodson State KansasSec. 21 (Blk.) 23 (Sur.) 14E Map No.Operator A. W. ThrockmortonWell No. 6 Farm OttoElev. Location C SE/41320 Ft. From S Line SE1320 Ft. From E Line Quarter1st. Report Oct 27 1954

Completion

Remarks

E. Sauder - Contr.

Spudding Date

Drlg. Data Wintershied PoolLocation

FABEN GILSTRAP

Map No. _____ Sec. 21 Twp. 23 R. 14EWell No. 6 Otto_____ A. W. Throckmorton Company

CORRECTION

_____ Contractor

SW NE SW

SECTION PLAT

_____ Ft. from N. Line

1600 Ft. from S. Line

_____ Ft. from E. Line

1600 Ft. from W. Line

Woodson County

Location _____

Rig up _____

Drilling and Remarks:

Reported

C SE/4

RECORD

Cased _____ in., _____ ft.

Sand _____

Gas _____

Oil _____

Total Depth _____

PRODUCTION

1st 24 hrs. Nat. _____

1st 24 hrs. after shot _____

Gas _____ Cu. Ft.

Dry Hole _____

Abandoned _____

Date


DEC

1 1954

19

FABEN GILSTRAP

Scout

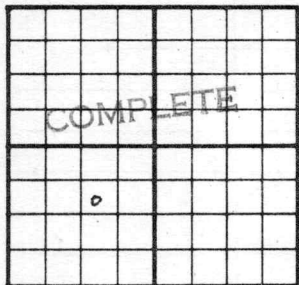County Woodson State KansasSec. 21 (Blk.
Twp.) 23 (Sur.
Rge.) 14E Map No.Operator A. W. ThrockmortonWell No. 6 Farm OttoElev. 1148 Location SW NE SW1600 Ft. From S Line SW1600 Ft. From W Line Quarter1st. ReportCompletion DEC 1 1954Remarks Wintershied PoolE. Sauder - Contr.Spudding Date 10-25-54Drlg. Data Oil well TD 16728" @ 818 Miss. chat 1645 Miss. lm. 1647TD 1672 4 $\frac{1}{2}$ " @ 1653 2000 AP/ 40 bopd Comp. 15 bopd

FABEN GILSTRAP