


Map No. _____ Sec. 21 Twp. 27 R. 4Well No. 3 Hene Farm _____Mcman

Company _____

NORTH

WEST

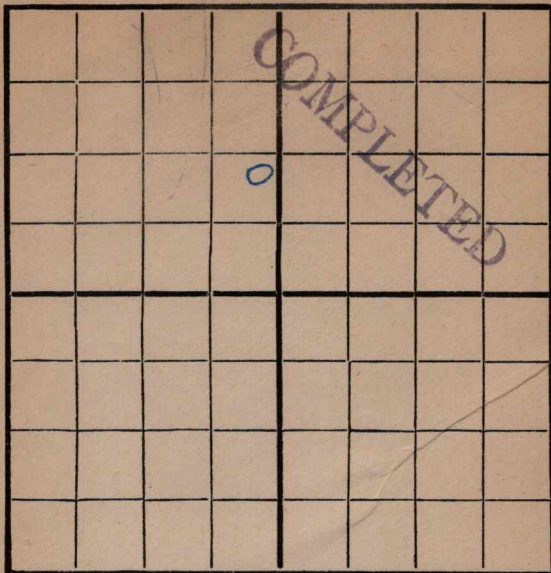

EAST

SOUTH

Location _____

Rig Up 9/6

Drilling Remarks

Drilling Remarks

10/2 Shut Down10/10 " "10/17 = 1923 = S.D. = 10/242029 = 11/9 =2305 = 11/14

RECORD

PRODUCTION

Cased _____ in. _____ Ft.

1st 24 hrs. Nat. _____

Sand _____

1st 24 hrs. after shot _____

Gas _____

Gas _____ Cu. Ft.

Oil _____


Dry Hole _____

Total Depth _____

Abandoned _____

Map No. _____ Sec. 21 Twp. 27 R. 4
 Well No. 3 Deer Farm
McKinn Company

NORTH

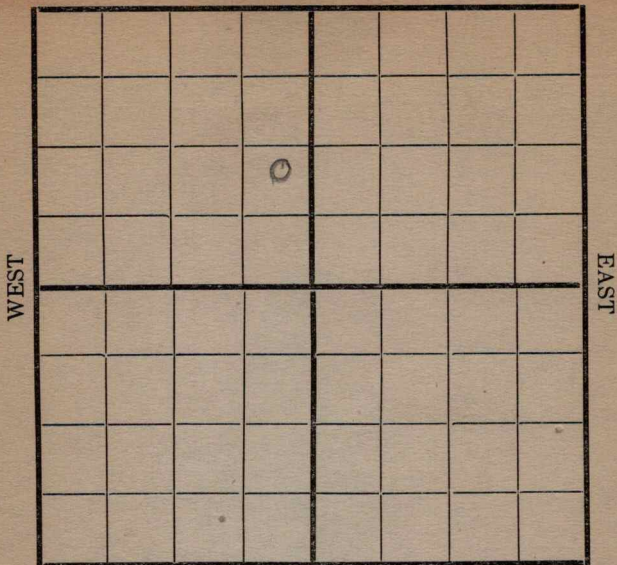

SOUTH

Location _____
 Rig Up _____
 Drilling and remarks _____

RECORD

Cased _____ in. _____ Ft.
 Sand _____
 Gas _____
 Oil _____
 Total Depth _____

PRODUCTION

1st 24 hrs. Nat. _____
 1st 24 hrs. after shot _____
 Gas _____ Cu. Ft.
 Dry Hole _____
 Abandoned _____

Date 9/6, 1916 6 H. Bailey Scout

Map No. _____ Sec. 21 Twp. 27 R. 4
 Well No. 3 Deaf Farm
McKee Company

NORTH

WEST

EAST

SOUTH

Location _____
 Rig Up _____
 Drilling and remarks

Wreck

RECORD

Cased _____ in. _____ Ft.
 Sand _____
 Gas _____
 Oil _____
 Total Depth _____

PRODUCTION

1st 24 hrs. Nat. _____
 1st 24 hrs. after shot _____
 Gas _____ Cu. Ft.
 Dry Hole _____
 Abandoned _____


Date

9/11, 1916 McKee Scout

Map No. _____ Sec. 21 Twp. 22 R. 4Well No. 3 Deep Farm _____

Company _____

NORTH

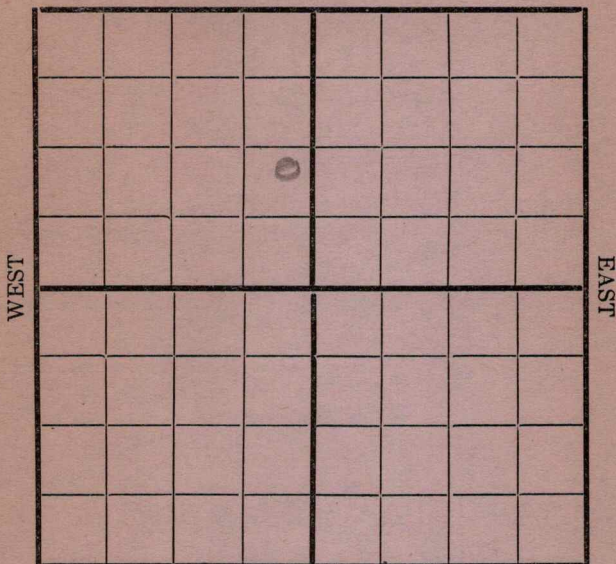

SOUTH

Location _____

Rig Up ☒ _____

Drilling and remarks _____

RECORD

Cased _____ in. _____ Ft.

Sand _____

Gas _____

Oil _____

Total Depth _____

PRODUCTION

1st 24 hrs. Nat. _____

1st 24 hrs. after shot _____

Gas _____ Cu. Ft.

Dry Hole _____

Abandoned _____

Date

9/19, 1916 Scout

Map No. _____ Sec. 27 Twp. 27 R. 4
Well No. 3 Dev Farm _____
Two Men Company

NORTH

WEST

EAST

SOUTH

Location _____

Rig Up-----

Drilling and remarks

RECORD

Cased _____ in. _____ Ft.

Sand _____

Gas -----

Oil _____

Total Depth.

PRODUCTION

1st 24 hrs. Nat.-----

First 24 hrs. after shot-----

Gas _____ Cu. Ft.

Dry Hole.....

Abandoned_ _ _ _ _


Date _____

Date 9/25-6 Scout 191 Scout

Map No. _____ Sec. 21 Twp. 27 R. 4
 Well No. 3 _____ Farm _____
 _____ Company

NORTH

WEST

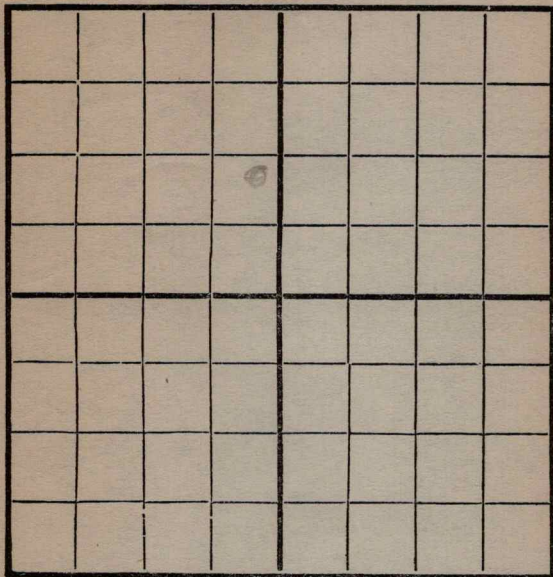

EAST

SOUTH

Location _____
 Rig Up _____
 Drilling and remarks _____

RECORD

Cased _____ in. _____ Ft.
 Sand _____
 Gas _____
 Oil _____
 Total Depth _____

PRODUCTION


1st 24 hrs. Nat. _____
 First 24 hrs. after shot _____
 Gas _____ Cu. Ft.
 Dry Hole _____
 Abandoned _____

Date

10/10, 191 6 Scout

Map No. _____ Sec. 21 Twp. 27 R. 4
 Well No. 3 Deep Farm _____
Musman Company _____

NORTH

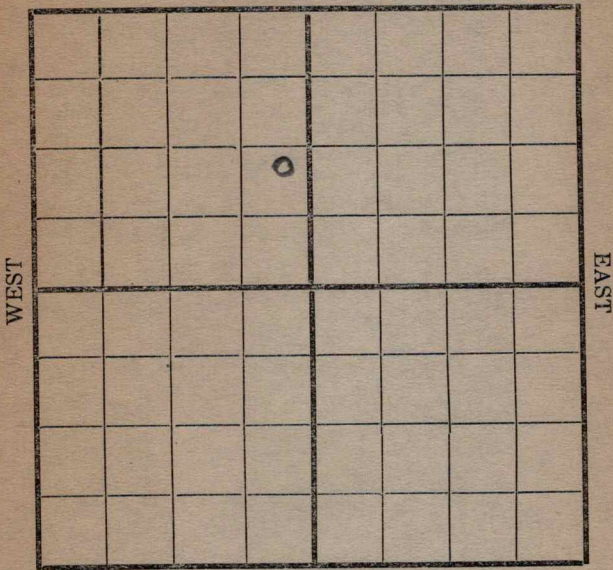

SOUTH

Location _____

Rig Up _____

Drilling and remarks

Shut Down
1923

RECORD

Cased _____ in. _____ Ft.

Sand _____

Gas _____

Oil _____

Total Depth _____

PRODUCTION

1st 24 hrs. Nat. _____

1st 24 hrs. after shot _____

Gas _____ Cu. Ft.

Dry Hole _____

Abandoned _____

Date


10/17 191 *6* *Leandiff* Scout

Map No. _____ Sec. 21 Twp. 27 R 4
 Well No. 3 Deep Farm _____
Anderson Company

NORTH

WEST

EAST

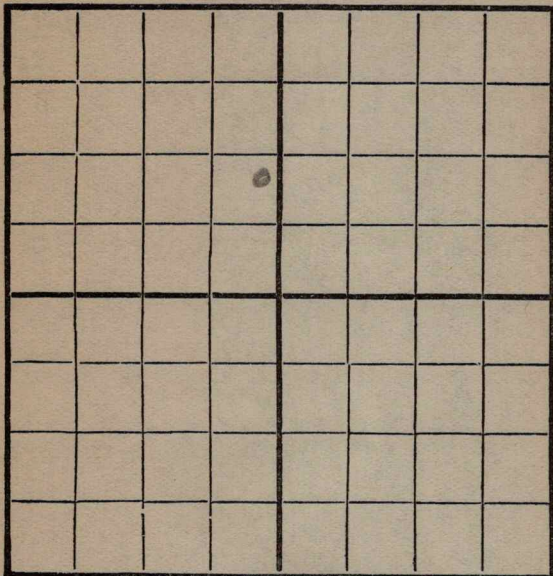

SOUTH

Location _____
 Rig Up _____
 Drilling and remarks

Shut Down

RECORD

Cased _____ in. _____ Ft.
 Sand _____
 Gas _____
 Oil _____
 Total Depth _____

PRODUCTION

1st 24 hrs. Nat. _____
 First 24 h. s. after shot _____
 Gas _____ Cu. Ft.
 Dry Hole _____
 Abandoned _____

Date


10/24, 191 6 Scout

Map No. _____ Sec. 21 Twp. 27 R. 4Well No. 3 Deaf Farm _____Ma. Man Company _____

NORTH

WEST

EAST

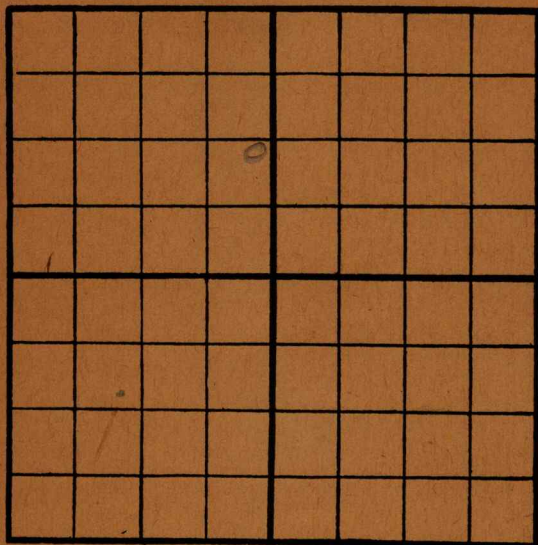

SOUTH

Location _____

Rig Up _____

Drilling and remarks

RECORD

Cased _____ in. _____ Ft.

Sand _____

Gas _____

Oil _____

Total Depth _____

PRODUCTION

1st 24 hrs. Nat. _____

1st 24 hrs. after shot _____

Gas _____ Cu. Ft.

Dry Hole _____


Abandoned _____

Date

10/30/06, 1916Scout McC

Map No. _____ Sec. 21 Twp. 27 R. 4
 Well No. 3 _____ Farm _____
 _____ Company _____

NORTH

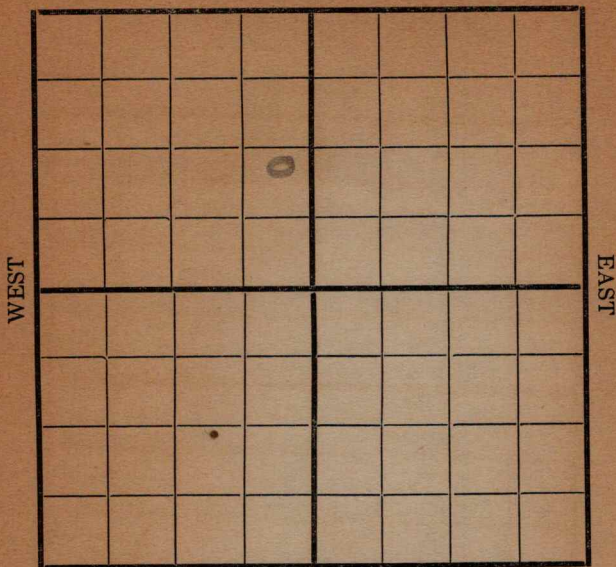

SOUTH

Location _____
 Rig Up _____
 Drilling and remarks _____

RECORD

Cased _____ in. _____ Ft.
 Sand _____
 Gas _____
 Oil _____
 Total Depth _____

PRODUCTION

1st 24 hrs. Nat. _____
 1st 24 hrs. after shot _____
 Gas _____ Cu. Ft.
 Dry Hole _____
 Abandoned _____


Date

11/9, 1916 W. H. H. H. H. Scout

Map No. _____ Sec. 21 Twp. 27 R. 4
 Well No. 3 _____ Farm _____
McCormick Company

NORTH

WEST

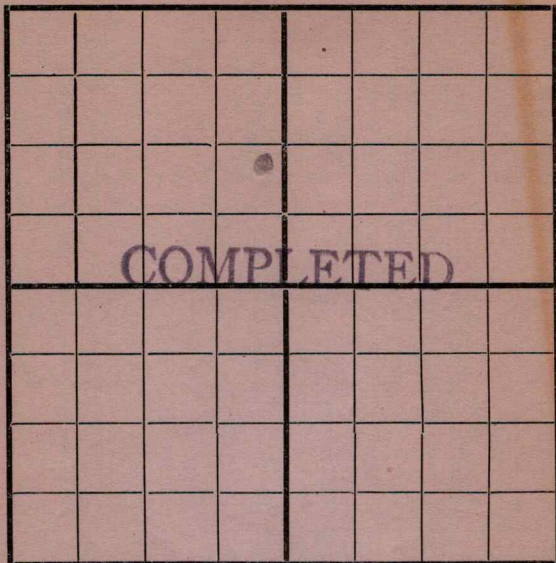

EAST

SOUTH

Location _____
 Rig Up _____
 Drilling and remarks _____

*Estimated
 at 350 bbls
 per day*

RECORD

Cased _____ in. _____ Ft.
 Sand 2326-2355
 Gas _____
 Oil _____
 Total Depth _____

PRODUCTION

1st 24 hrs. Nat. _____
 1st 24 hrs. after shot _____
 Gas _____ Cu. Ft.
 Dry Hole _____
 Abandoned _____

Date

11/20, 1916 Carlyle Scout