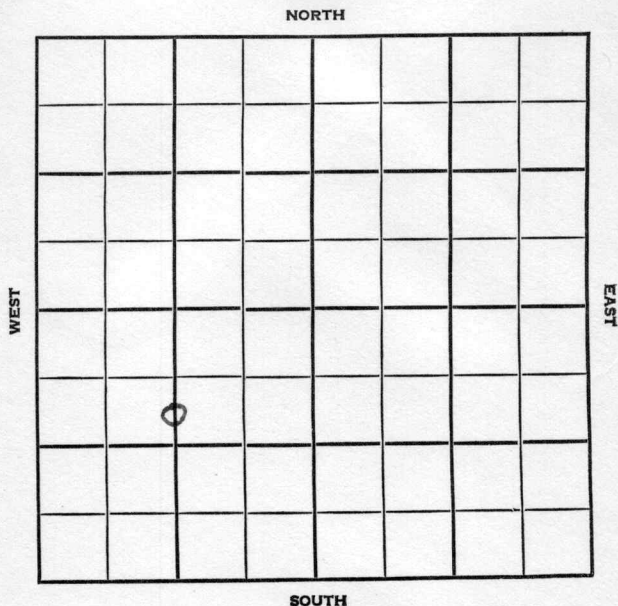


Section 21 Township 23S Range 14EWell No. 7 OttoCompany A. W. Throckmorton

SEC.	TWP.	R.
21	23S	14E

WELL NO.

#7 Otto

FARM

COMPANY

A.W. Throckmorton

CONTRACTOR

Sauder Drlg. Tools.

990

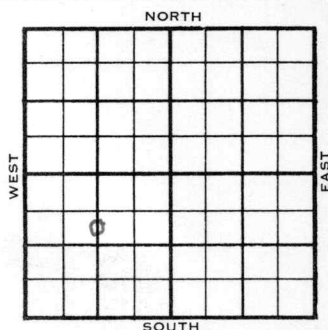
Ft. from N. Line

Ft. from S. Line

Ft. from E. Line

1320

Ft. from W. Line

C S $\frac{1}{2}$ N $\frac{1}{2}$ SW

1954

ELEVATION

1155'

REPORT

12/15 Spud 11-29-54
 Drig. 1295'

12/22 Spud 11-29-54 Oil well TD 1671
 Miss. 1652 TD 1671 5" @ 1659
 Miss lime 1670 CO to 1671
 FU 170' oil 2000 A Comp. 85 BOPD

COMPLETED

County **Woodson** State **Kansas**

Sec. **21** (Blk. **23S** (Sur. **14E** Map No.

Operator A. W. Throckmorton

Well No. 7 Farm Otto

Elev.	1155	Location	C S $\frac{1}{2}$ N $\frac{1}{2}$ SW
-------	------	----------	--------------------------------------

FIRST REPORT

990 Ft. From N Line SW

1320 Ft. From W Line Quarter

1st. Report DEC 8 1954

Completion

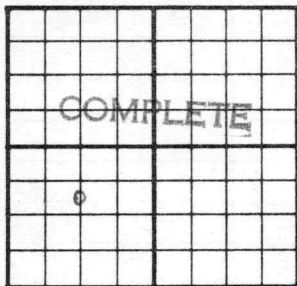
Remarks	Sauder Drlg tools
---------	-------------------

Spudding Date **11-29-54**

Drlg. Data

Dr1g. 1295

FABEN GILSTRAP

County Woodson State KansasSec. 21 (Blk.
Twp.) 23 (Sur.
Rge.) 14E Map No.Operator A. W. ThrockmortonWell No. 7 Farm OttoElev. 1155 Location C S $\frac{1}{2}$ N $\frac{1}{2}$ SW990 Ft. From N Line SW1320 Ft. From W Line Quarter1st. ReportCompletion DEC 22 1954RemarksSauder Drlg. - Contr.Spudding Date 11-29-54Drlg. Data Oil well TD 1671Miss. 1652 TD 1671 5" @ 1659Miss. lime 1670 CO to 1671 FU 170' oil2000N Comp. 85 bopd

FABEN GILSTRAP