

Map No. _____ Sec 21 Twp 27 R 4Well No. 5 - Deal Farm _____M. Man Company _____

NORTH

WEST

EAST

SOUTH

Location _____

Rig Up 10/17/16

Drilling Remarks:

Drilling Remarks:

R. H. 10/24-11/9:90 = 11/14580 = 11/271275 = 12/41625 = 12/111820 = 12/181985 = 12/282435 = 1/8/17 = 8202480 - In sand = 4/7

RECORD

PRODUCTION

Cased _____ in _____ Ft.

1st 24 hrs. Nat. _____

Sand _____

1st 24 hrs. after shot _____

Gas _____

Gas _____ Cu. Ft.

Oil _____

Dry Hole _____


Total Depth _____

Abandoned _____

Map No. _____ Sec. 21 Twp. 27 R. 4
 Well No. 3 Deep _____ Farm
McMurry _____ Company

NORTH

WEST

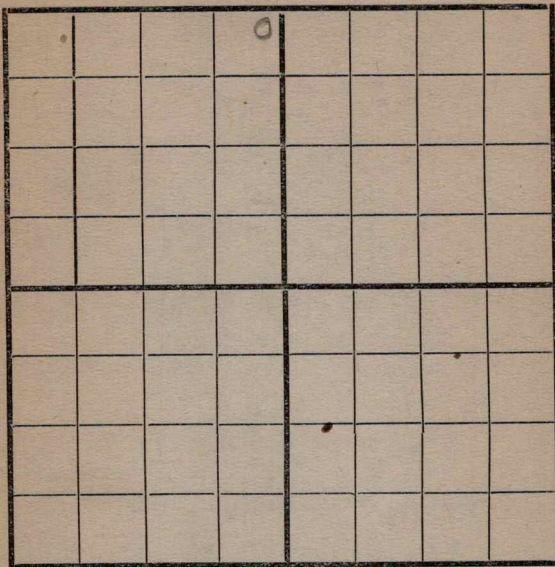

EAST

SOUTH

Location _____
 Rig Up ✓ _____
 Drilling and remarks _____

RECORD

Cased _____ in. _____ Ft.
 Sand _____
 Gas _____
 Oil _____
 Total Depth _____

PRODUCTION

1st 24 hrs. Nat. _____
 1st 24 hrs. after shot _____
 Gas _____ Cu. Ft.
 Dry Hole _____
 Abandoned _____

Date

10/17 1916 Scout Scout

Map No. _____ Sec. 27 Twp. 27 R. 9

Well No. 5 Farm Marion
Company

NORTH

WEST

EAST

SOUTH

Location _____

Rig Up _____

Drilling and remarks

RECORD

Cased _____ in. _____ Ft.

Sand

Gas

Oil_____

Total Depth.....

PRODUCTION

1st 24 hrs. Nat.-----

First 24 h_s. after shot_____

Gas _____ Cu. Ft.

Dry Hole -----

Abandoned-----

Date _____


191 Scout

Map No. _____ Sec. 21 Twp. 27 R. 4Well No. 5 Deep Farm _____McWane Company _____

NORTH

WEST

EAST

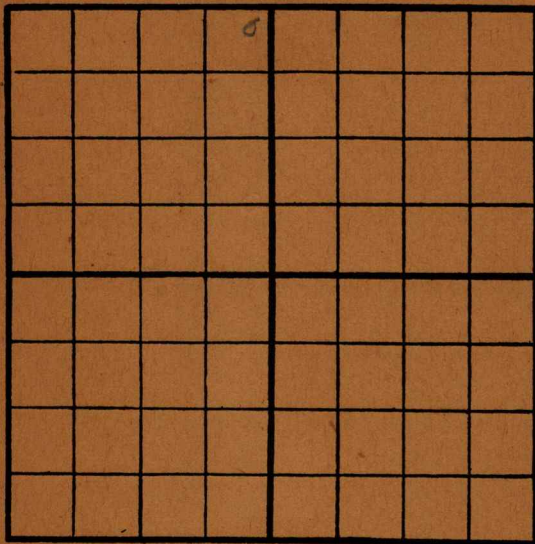

SOUTH

Location _____

Rig Up _____

Drilling and remarks _____

RECORD

Cased _____ in. _____ Ft.

Sand _____

Gas _____

Oil _____

Total Depth _____

PRODUCTION

1st 24 hrs. Nat. _____

1st 24 hrs. after shot _____

Gas _____ Cu. Ft.

Dry Hole _____

Abandoned _____


Date

10/30, 1916 _____ Scout

Map No. _____ Sec. 21 Twp. 27 R. 4
 Well No. 5-2-21-27-4 Farm _____
 _____ Company

NORTH

WEST

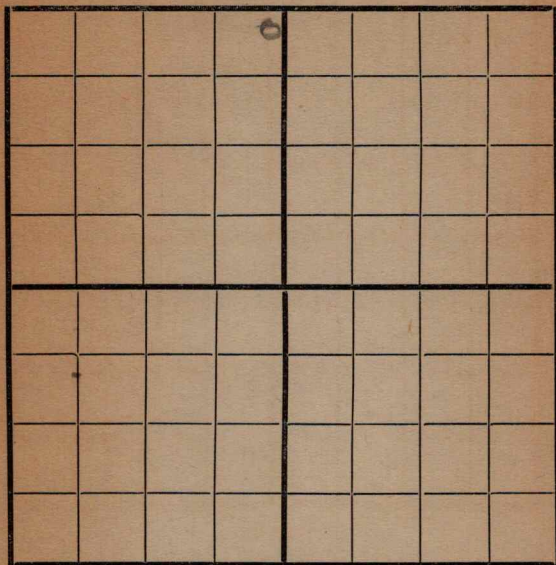

EAST

SOUTH

Location ✓
 Rig Up ✓
 Drilling and remarks

RECORD

Cased _____ in. _____ Ft.
 Sand _____
 Gas _____
 Oil _____
 Total Depth _____

PRODUCTION

1st 24 hrs. Nat. _____
 1st 24 hrs. after shot _____
 Gas _____ Cu. Ft.
 Dry Hole _____
 Abandoned _____

Date

11/9, 1916 Scout

Map No. _____ Sec. 21 Twp. 22 R. 4
 Well No. 5 Deep Farm _____
 _____ Company

NORTH

WEST				0					EAST

SOUTH

Location _____
 Rig Up _____
 Drilling and remarks

90

RECORD

Cased _____ in. _____ Ft.
 Sand _____
 Gas _____
 Oil _____
 Total Depth _____

PRODUCTION

1st 24 hrs. Nat. _____
 1st 24 hrs. after shot _____
 Gas _____ Cu. Ft.
 Dry Hole _____
 Abandoned _____

Date

11/14, 1916 Cardiff Scout

Map No. _____ Sec. 21 Twp. 27 R. 4
 Well No. 5 Deep Farm _____
Mrs. Moore Company _____

NORTH

WEST				0					EAST

SOUTH

Location _____
 Rig Up _____
 Drilling and remarks _____

580

RECORD

Cased _____ in. _____ Ft.
 Sand _____
 Gas _____
 Oil _____
 Total Depth _____

PRODUCTION

1st 24 hrs. Nat. _____
 1st 24 hrs. after shot _____
 Gas _____ Cu. Ft.
 Dry Hole _____
 Abandoned _____

Date

11/20 191 6 Quiliff Scout

Map No. _____ Sec. 21 Twp. 27 R. 4
 Well No. 5 Deaf Farm
Marion Company

NORTH

WEST

EAST

SOUTH

Location _____
 Rig Up _____
 Drilling and remarks

RECORD

Cased _____ in. _____ Ft.
 Sand _____
 Gas _____
 Oil _____
 Total Depth _____

PRODUCTION

1st 24 hrs. Nat. _____
 1st 24 hrs. after shot _____
 Gas _____ Cu. Ft.
 Dry Hole _____
 Abandoned _____

Date

11/27, 191


6 Cordell Scout

Map No. _____ Sec. 21 Twp. 27 R. 4Well No. 5 Seal Farm _____Company McMan _____

NORTH

WEST

EAST

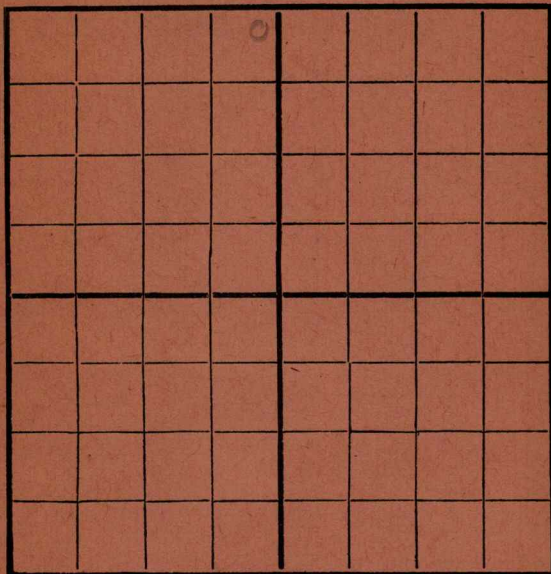

SOUTH

Location _____

Rig Up _____

Drilling and remarks

1275

RECORD

Cased _____ in. _____ Ft.

Sand _____

Gas _____

Oil _____

Total Depth _____

PRODUCTION

1st 24 hrs. Nat. _____

1st 24 hrs. after shot _____

Gas _____ Cu. Ft.

Dry Hole _____

Abandoned _____

Date


10/4, 1916 Cordiff Scout

Map No. _____ Sec. 21 Twp. 27 R. 4
 Well No. 5 D-2-2-1 Farm _____
McKean Company _____

NORTH

WEST

EAST

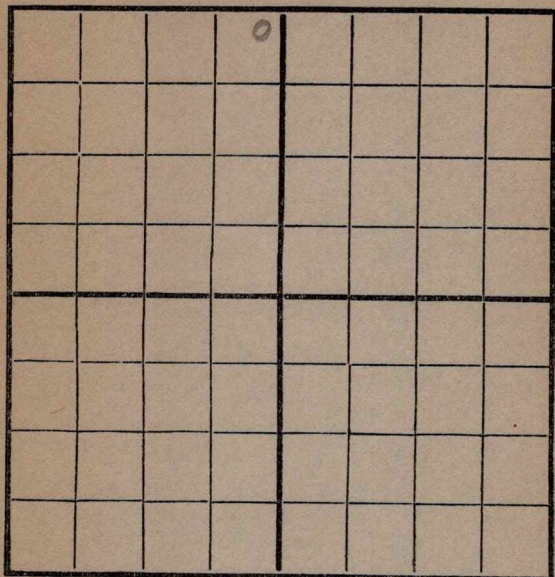

SOUTH

Location _____

Rig Up _____

Drilling and remarks

RECORD

Cased _____ in. _____ Ft.

Sand _____

Gas _____

Oil _____

Total Depth _____

PRODUCTION

1st 24 hrs. Nat. _____

1st 24 hrs. after shot _____

Gas _____ Cu. Ft.

Dry Hole _____

Abandoned _____

Date

12/11, 1916, C. C. C. Scout

Map No. _____ Sec. 21 Twp. 27 R. 4Well No. 5-Deaf Farm _____Company Union

NORTH

WEST

EAST

SOUTH

Location _____

Rig Up _____

Drilling and remarks

1820

RECORD

Cased _____ in. _____ Ft.

Sand _____

Gas _____

Oil _____

Total Depth _____

PRODUCTION

1st 24 hrs. Nat. _____

1st 24 hrs. after shot _____

Gas _____ Cu. Ft.

Dry Hole _____

Abandoned _____

Date

12/28, 1916 Candiff Scout


Map No. _____ Sec. 21 Twp. 27 R. 4

Well No. 5222 Farm _____

Missouri Company _____

NORTH

WEST

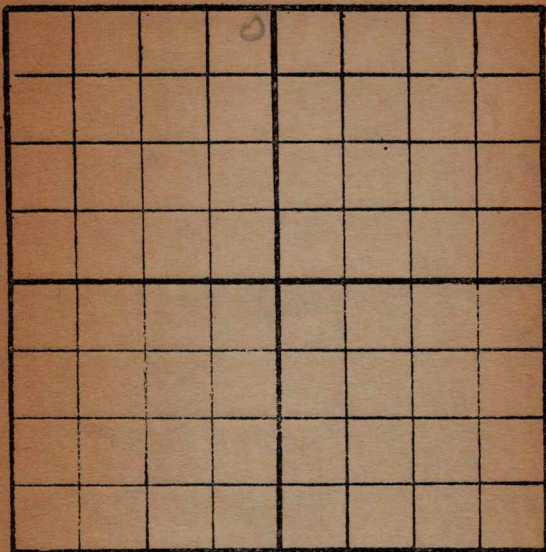

EAST

SOUTH

Location _____

Rig up _____

Drilling and remarks:

1985

RECORD

Cased _____ in. _____ Ft.

Sand _____

Gas _____

Oil _____

Total Depth _____

PRODUCTION

1st. 24 hrs. Nat. _____

1st. 24 hrs. after shot _____

Gas _____ Cu. Ft.

Dry Hole _____


Abandoned _____

Date

12/28, 1916, 6 Co. 100 Scout

Map No. _____ Sec. 21 Twp. 27 R. 4
Well No. 522 Farm _____
McMan Company _____

NORTH

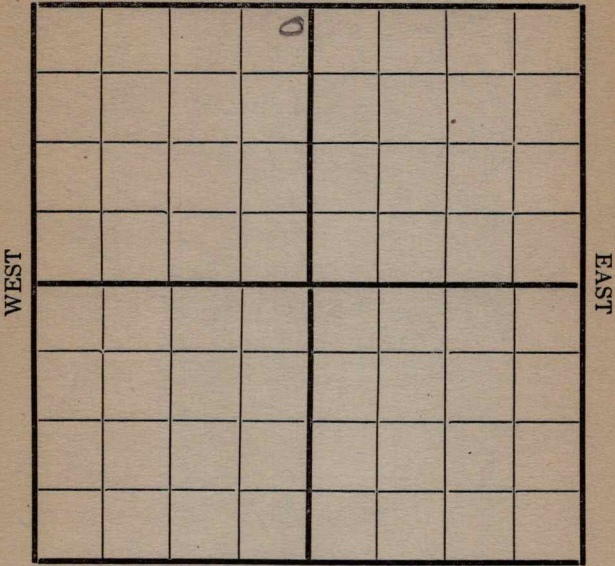

SOUTH

Location _____
Rig Up _____
Drilling and remarks _____
21 35

RECORD

Cased _____ in. _____ Ft.
Sand _____
Gas _____
Oil _____
Total Depth _____

PRODUCTION


1st 24 hrs. Nat. _____
1st 24 hrs. after shot _____
Gas _____ Cu. Ft.
Dry Hole _____
Abandoned _____

Date 1/1, 1917 Cardiff Scout

Map No. _____ Sec. 21 Twp. 27 R. 4
 Well No. 5 Deaf Farm _____
McNair Company _____

NORTH

WEST

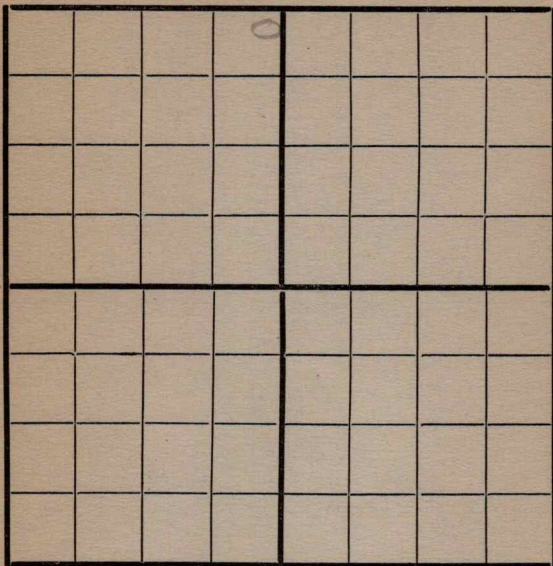

EAST

SOUTH

Location _____

Rig Up _____

Drilling and remarks

Top of sand
2435'
at 10' feet in
a slight show

RECORD

Cased _____ in. _____ Ft.

Sand 2435'

Gas _____

Oil _____

Total Depth _____

PRODUCTION

1st 24 hrs. Nat. _____

1st 24 hrs. after shot _____

Gas _____ Cu. Ft.

Dry Hole _____

Abandoned _____


Date

1/8, 1917 *Conley* Scout

Map No. _____ Sec. 21 Twp. 27 R. 4
 Well No. 5 Seal Farm _____
McNamee Company _____

NORTH

WEST

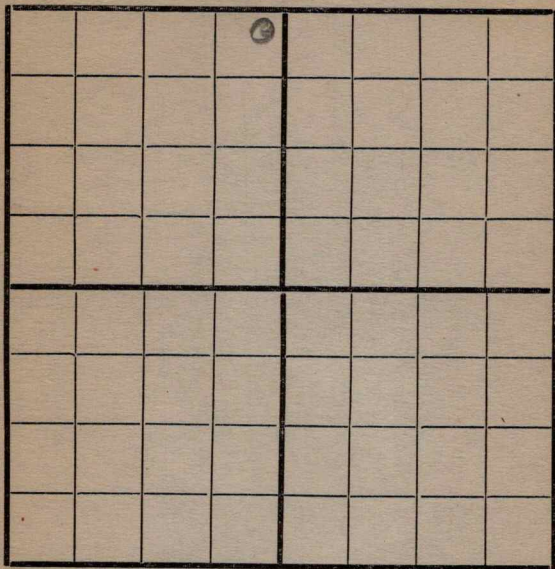

EAST

SOUTH

Location _____
 Rig Up _____
 Drilling and remarks _____

*Looks like
 a bad
 one
 no showing*

RECORD

Cased _____ in. _____ Ft.
 Sand 2435-2480
 Gas _____
 Oil _____
 Total Depth _____


PRODUCTION

1st 24 hrs. Nat. _____
 1st 24 hrs. after shot _____
 Gas _____ Cu. Ft.
 Dry Hole _____
 Abandoned _____

Date

1/17, 1917 Condy Scout

Map No. 11 Sec. 21 Twp. 27 R. 4
 Well No. 5-2-e-1 Farm _____
Mc Mohr Company _____

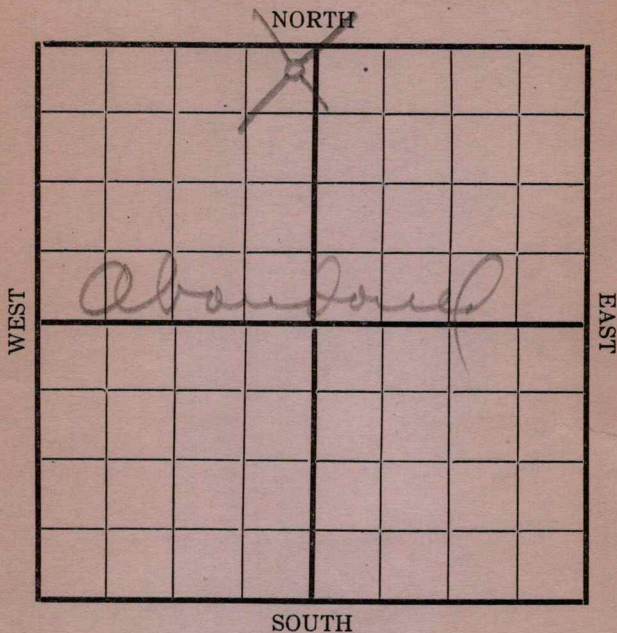

Location _____
 Rig Up _____
 Drilling and remarks _____

*Dry and
 Plugged at
 2485*

RECORD

Cased _____ in. _____ Ft.
 Sand _____
 Gas _____
 Oil _____
 Total Depth _____

PRODUCTION

1st 24 hrs. Nat. _____
 1st 24 hrs. after shot _____
 Gas _____ Cu. Ft.
 Dry Hole _____
 Abandoned _____

Date _____

1/22, 1917 Con D. J. Scout

MAP NO. KANSAS SEC. 21 TWP. 27S R. 4E

WELL NO. 5 Deal

M. E. Man COMPANY

CONTRACTOR

SECTION PLAT

ABANDONED

_____ FT. FROM N. LINE

_____ FT. FROM S. LINE


_____ FT. FROM E. LINE

_____ FT. FROM W. LINE

LOCATION _____

RIG UP _____

DRILLING AND REMARKS:

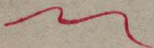

RECORD

CASED _____ IN. _____ FT.

SAND _____

GAS _____

OIL _____

TOTAL DEPTH 2485

PRODUCTION

1ST 24 HRS. NAT. _____

1ST 24 HRS. AFTER SHOT _____

GAS _____ CU. FT.

DRY HOLE ☒

ABANDONED ☒

DATE

1-24 17 192 SCOUT