


Woodson

Form 51-5M-2-29-34703

Map No. **KANSAS** Sec. 21 Twp. 23 R. 14

Well No. Opita P & R Beek Farm _____ Company _____

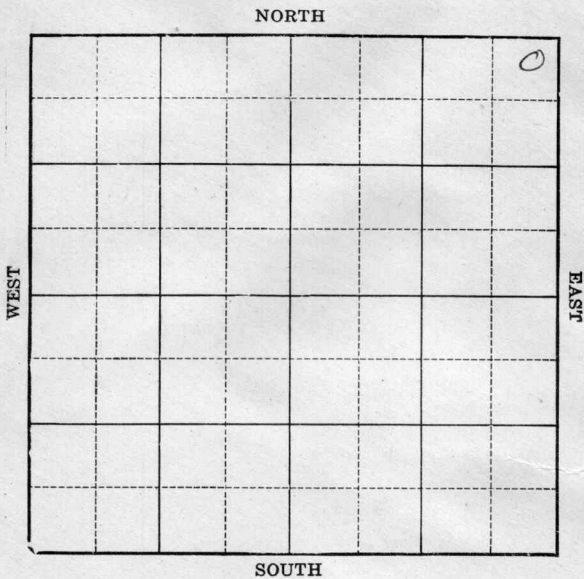

Location _____
Drilling Remarks _____

Rig Up _____
Drilling Remarks _____

RECORD

Cased _____ in. _____ ft.
Sand _____
Gas _____
Oil _____
Total Depth _____

PRODUCTION

1st 24 hrs. Nat. _____
1st 24 hrs. after shot _____
Gas _____ cu. ft.
Dry Hole _____
Abandoned _____

Woodson

Map No. _____ Sec. 21 Twp. 23 R. 14Well No. 1 Deep _____Oklahoma _____ Company

_____ Contractor

FIRST REPORTS
COMPLETED

SECTION PLAT

_____ Ft. from N. Line

_____ Ft. from S. Line

_____ Ft. from E. Line

_____ Ft. from W. Line

Location _____

Rig up _____

Drilling and Remarks:

Log 1704-10'4073 Bls.

RECORD

Cased _____ in., _____ ft.

Sand 1694-1710

Gas _____

Oil _____

Total Depth 1710

PRODUCTION

1st 24 hrs. Nat. _____

1st 24 hrs. after shot _____

Gas _____ Cu. Ft.

Dry Hole _____

Abandoned _____

Date

10/19/21 192 _____Sherwood Scout