


Map No. _____ Sec 21 Twp 27 R 4Well No. H Deal Farm _____McMan Company _____

NORTH

WEST

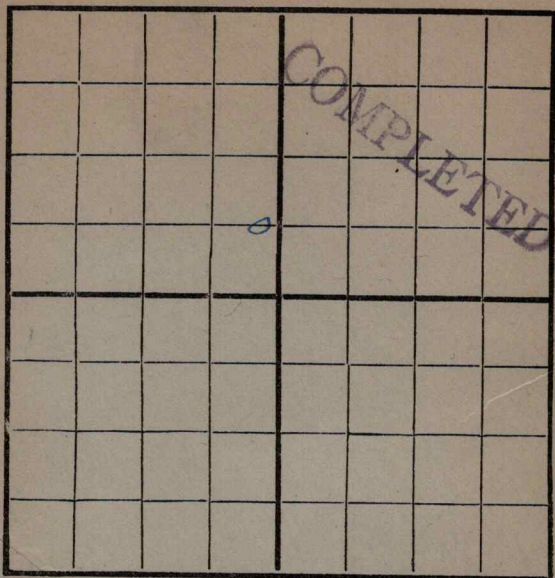

EAST

SOUTH

Location _____

Rig Up 10/17/16

Drilling Remarks:

Drilling Remarks:

10/24-
4/50 = 11/9-
895 = 11/14-
1150 = 11/27
1750 = 12/4
1960 = 12/11-
2100 = 12/18
2334 = 12/28

RECORD

Cased _____ in _____ Ft.
 Sand _____
 Gas _____
 Oil _____
 Total Depth _____

PRODUCTION

1st 24 hrs. Nat. _____
 1st 24 hrs. after shot _____
 Gas _____ Cu. Ft.
 Dry Hole _____
 Abandoned _____

Map No. _____ Sec. 21 Twp. 27 R. 4
 Well No. 4 Deep Farm _____
McMan Company _____

NORTH

WEST

EAST

SOUTH

Location _____
 Rig Up _____
 Drilling and remarks _____

RECORD

Cased _____ in. _____ Ft.
 Sand _____
 Gas _____
 Oil _____
 Total Depth _____

PRODUCTION

1st 24 hrs. Nat. _____
 1st 24 hrs. after shot _____
 Gas _____ Cu. Ft.
 Dry Hole _____
 Abandoned _____

Date


10/17 1916 Scout

Map No. _____ Sec. 21 Twp. 22 R. 4
 Well No. 4 Deep Farm _____
McNair Company _____

NORTH

WEST

EAST

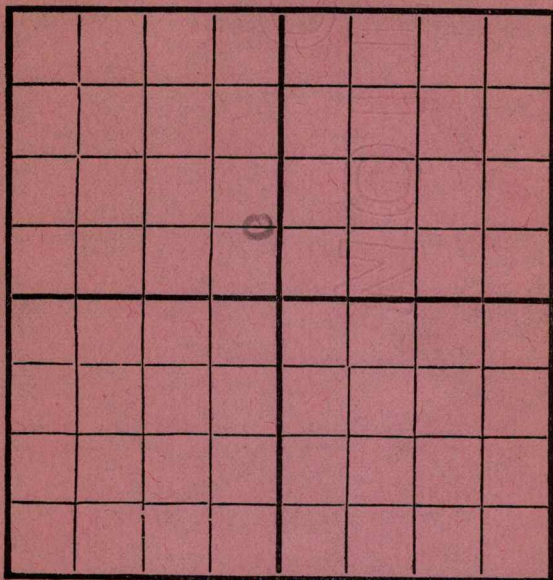

SOUTH

Location ✓
 Rig Up ✓
 Drilling and remarks _____

RECORD

Cased _____ in. _____ Ft.
 Sand _____
 Gas _____
 Oil _____
 Total Depth _____

PRODUCTION

1st 24 hrs. Nat. _____
 First 24 h. s. after shot _____
 Gas _____ Cu. Ft.
 Dry Hole _____
 Abandoned _____

Date


10/24, 1916 L. L. Co. & Co. Scout

Map No. _____ Sec. 21 Twp. 22 R. 4
 Well No. 4 Deep Farm _____
McKean Company

NORTH

WEST

EAST

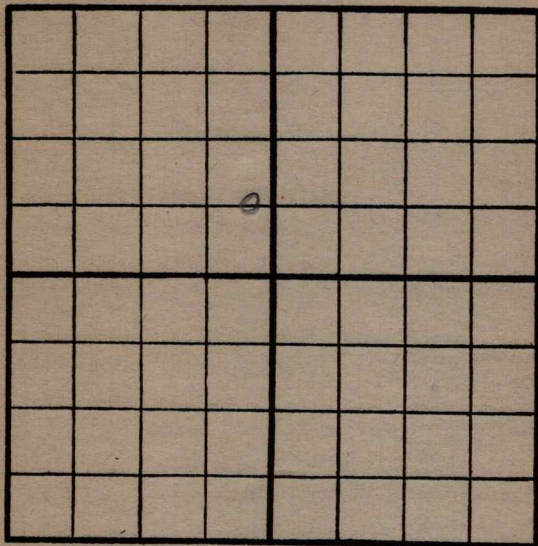

SOUTH

Location _____

Rig Up _____

Drilling and remarks

Spudding

RECORD

Cased _____ in. _____ Ft.

Sand _____

Gas _____

Oil _____

Total Depth _____

PRODUCTION

1st 24 hrs. Nat. _____

1st 24 hrs. after shot _____

Gas _____ Cu. Ft.

Dry Hole _____

Abandoned _____

Date

10/30, 191*6* *See*


Scout

Map No. _____ Sec. 21 Twp. 27 R. 4
 Well No. 4 _____ Farm _____
 _____ Company _____

NORTH

WEST

EAST

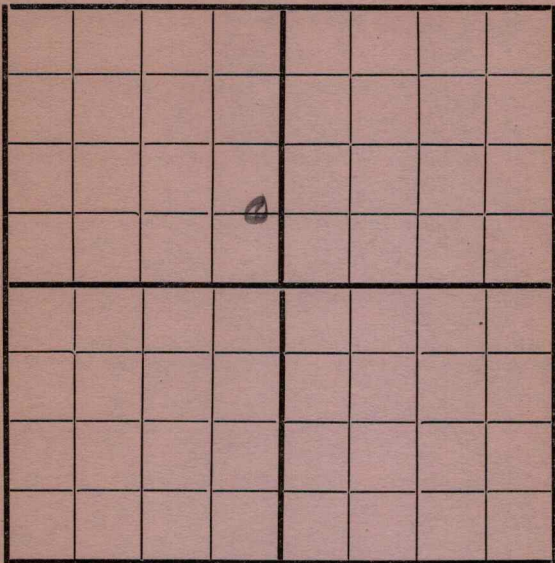

SOUTH

Location _____

Rig Up _____

Drilling and remarks

450

RECORD

Cased _____ in. _____ Ft.

Sand _____

Gas _____

Oil _____

Total Depth _____

PRODUCTION

1st 24 hrs. Nat. _____

1st 24 hrs. after shot _____

Gas _____ Cu. Ft.

Dry Hole _____


Abandoned _____

Date

11/19, 1916 G. B. B. B. Scout

Map No. _____ Sec. 21 Twp. 27 R. 4
 Well No. 4 Deere Farm _____
Union Company

NORTH

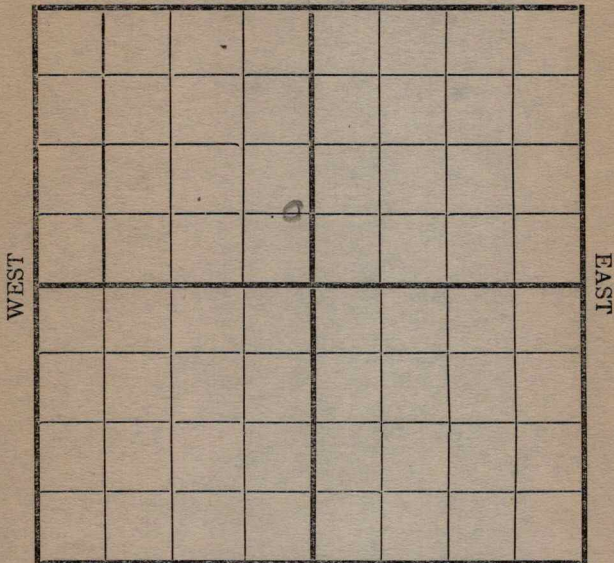

SOUTH

Location _____

Rig Up _____

Drilling and remarks

895-

RECORD

Cased _____ in. _____ Ft.

Sand _____

Gas _____

Oil _____

Total Depth _____

PRODUCTION

1st 24 hrs. Nat. _____

1st 24 hrs. after shot _____

Gas _____ Cu. Ft.

Dry Hole _____


Abandoned _____

Date

1/14, 1916 Co. 21 Scout

Map No. _____ Sec. 21 Twp. 27 R. 4
 Well No. 42 Farm _____
No Name Company _____

NORTH

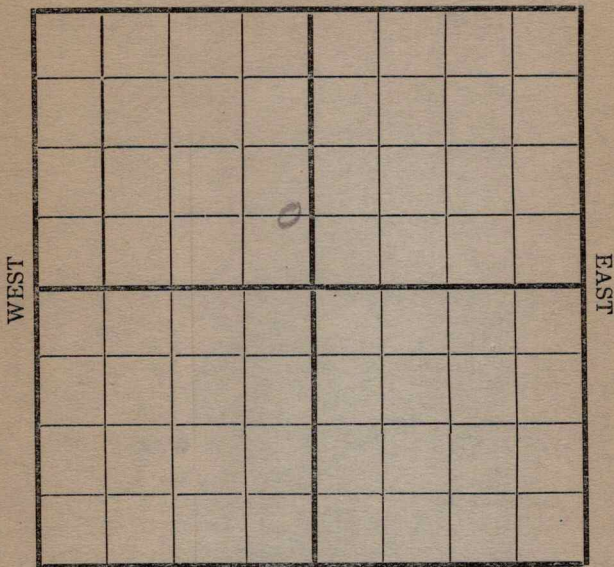

SOUTH

Location _____
 Rig Up _____
 Drilling and remarks _____

1100

RECORD

Cased _____ in. _____ Ft.
 Sand _____
 Gas _____
 Oil _____
 Total Depth _____

PRODUCTION

1st 24 hrs. Nat. _____
 1st 24 hrs. after shot _____
 Gas _____ Cu. Ft.
 Dry Hole _____
 Abandoned _____

Date

11/20 1916 Cordy Scout

Map No. _____ Sec. 21 Twp. 27 R. 4
 Well No. 4 Deal Farm _____
Marion Company

NORTH

WEST

EAST

SOUTH

Location _____

Rig Up _____

Drilling and remarks

1150'

RECORD

Cased _____ in. _____ Ft.

Sand _____

Gas _____

Oil _____

Total Depth _____

PRODUCTION

1st 24 hrs. Nat. _____

1st 24 hrs. after shot _____

Gas _____ Cu. Ft.

Dry Hole _____

Abandoned _____

Date


11/27 191 6 Cady Scout

Map No. _____ Sec. 21 Twp. 27 R. 4
 Well No. 4 Deel Farm _____
McMan Company _____

NORTH

WEST

EAST

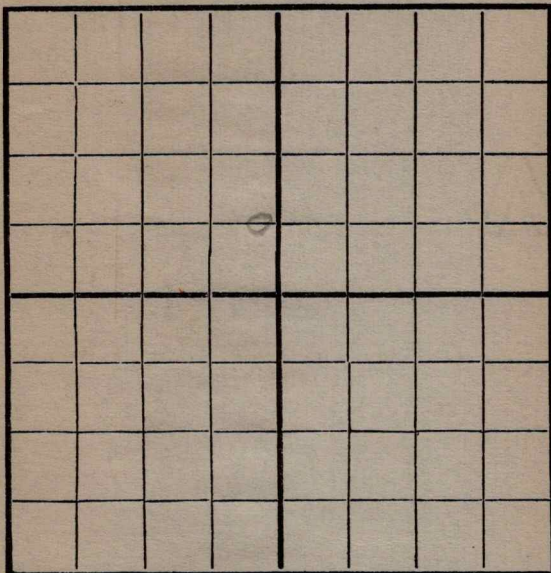

SOUTH

Location _____
 Rig Up _____
 Drilling and remarks _____

1750'

RECORD

Cased _____ in. _____ Ft.
 Sand _____
 Gas _____
 Oil _____
 Total Depth _____

PRODUCTION

1st 24 hrs. Nat. _____
 1st 24 hrs. after shot _____
 Gas _____ Cu. Ft.
 Dry Hole _____
 Abandoned _____

Date


12/4, 1916, Cardiff Scout

Map No. _____ Sec. 21 Twp. 27 R. 4
 Well No. 4 _____ Farm _____
 _____ Company _____

NORTH

WEST

EAST

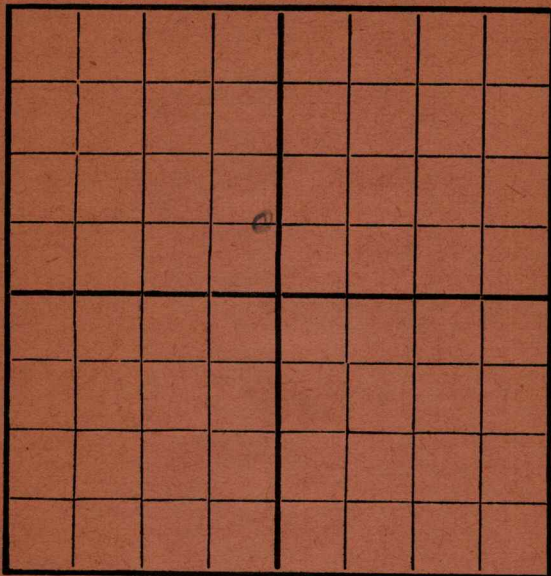

SOUTH

Location _____
 Rig Up _____
 Drilling and remarks _____

RECORD

Cased _____ in. _____ Ft.
 Sand _____
 Gas _____
 Oil _____
 Total Depth _____

PRODUCTION

1st 24 hrs. Nat. _____
 1st 24 hrs. after shot _____
 Gas _____ Cu. Ft.
 Dry Hole _____
 Abandoned _____

Date


12/11, 1916, _____ Scout

Map No. _____ Sec. 21 Twp. 27 R. 4

Well No. 4 Deal Farm _____
Anderson Company

NORTH

WEST

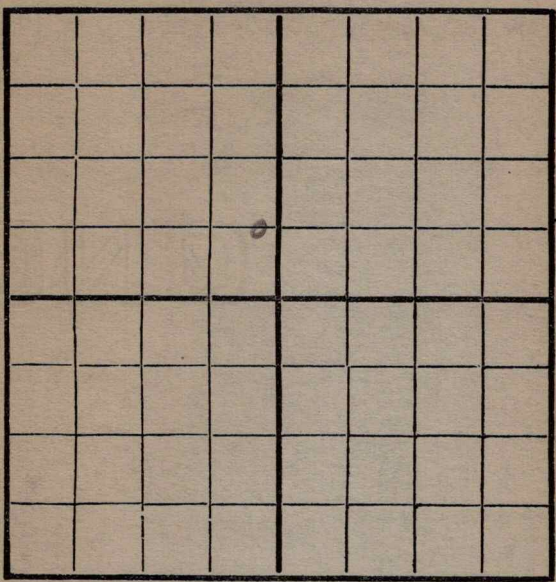

EAST


SOUTH

Location _____ Rig Up _____ Drilling and remarks <u>2100</u>	RECORD Cased _____ in. _____ Ft. Sand _____ Gas _____ Oil _____ Total Depth _____ PRODUCTION 1st 24 hrs. Nat. _____ 1st 24 hrs. after shot _____ Gas _____ Cu. Ft. Dry Hole _____ Abandoned _____
--	---

Date 12/18, 1916 Anderson Scout

Map No. _____ Sec. 21 Twp. 27 R. 4

Well No. 4 Deal Farm _____
McKee Company _____

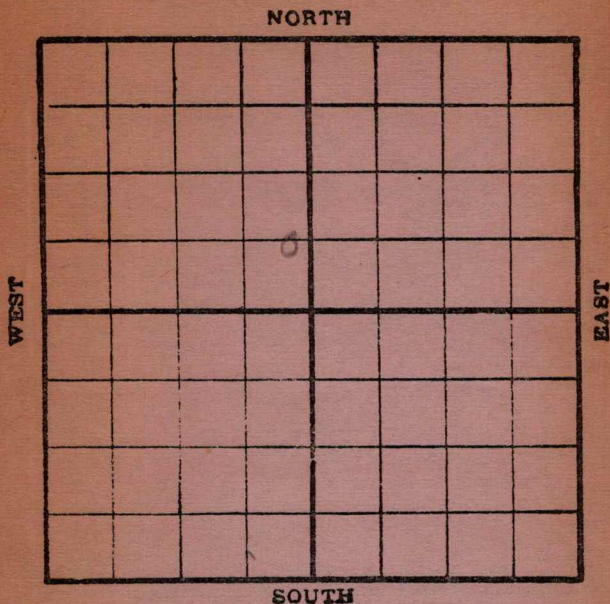

Location _____

Rig up _____

Drilling and remarks:

2334

RECORD

Cased _____ in. _____ Ft.

Sand _____

Gas _____

Oil _____

Total Depth _____

PRODUCTION

1st. 24 hrs. Nat. _____

1st. 24 hrs. after shot _____

Gas _____ Cu. Ft.

Dry Hole _____

Abandoned _____


Date

Feb 6 1916 Scout _____

Map No. _____ Sec. 21 Twp. 27 R. 4
 Well No. 4 Deep Farm _____
McNair Company _____

NORTH

WEST

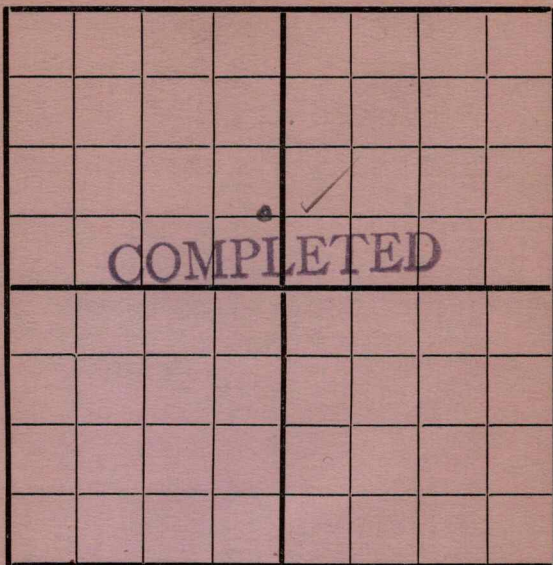

EAST

SOUTH

Location _____

Rig Up _____

Drilling and remarks

Estimated
at 500 Bbls

RECORD

Cased _____ in. _____ Ft.

Sand 2321-2360

Gas _____

Oil _____

Total Depth _____

PRODUCTION

1st 24 hrs. Nat. _____

1st 24 hrs. after shot _____

Gas _____ Cu. Ft.

Dry Hole _____

Abandoned _____

Date

1/1, 1917 Condeff Scout