


Section 21 Township 23 Range 14E

Well No. #1 West Otto

Company R. E. French

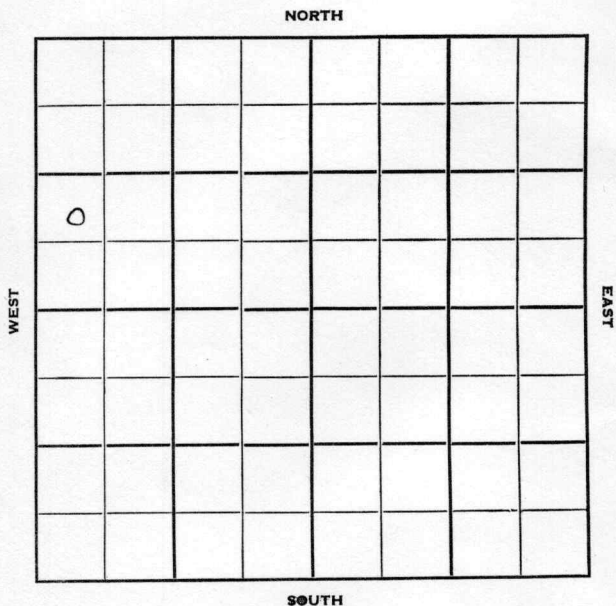

Woodson

KANSAS

Sec. 21 Twp. 23 R. 14E

Well No. #1 West Otto Farm

R. E. French Company

Sunflower Contractor


Ft. from N. Line

990 Ft. from S. Line

Ft. from E. Line

330 Ft. from W. Line

NW SW NW

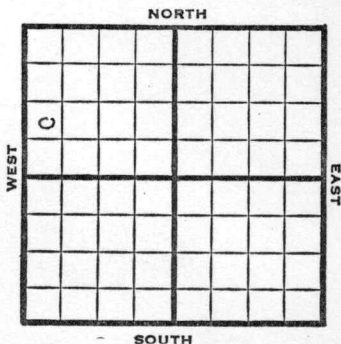

1952

REPORT

1/30

Spud 1-17-52
8" @ 351'

Drlg. 1625'

2/6

5" @ 1638

Drlg. 1660'

2/13

TD 1630' 2' DP

2/19

Spud 1-17-52 TD 1604'

Oil Well TD 1658

8" @ 351 Miss. 1623 5" @ 1630

TD 1658 Comp. 8 bopd

COMPLETED

County Woodson State Kansas

Sec. **21** (Blk.) **23** (Sur.) **14E** Map No.

Operator R. E. French

Well No. 1 Farm West Otto

Elev.	Location	NW	SW	NW
-------	----------	----	----	----

990 Ft. From S Line NW

330 Ft. From **W** Line Quarter1st. Report **JAN 30 1952**

Completion

Remarks

Sunflower - Contr.

Spudding Date **1-17-52**

Drlg. Data

~~8" @ 351 Drlg. 1625~~

J. G. McGEHEE

County Woodson State Kansas
 Sec. 21 (Blk.) 23 (Sur.) 14E Map No.
 Operator R. E. French
 Well No. 1 Farm West Otto
 Elev. _____ Location NW SW NW

0

COMPLETE

990 Ft. From S Line NW
330 Ft. From W Line Quarter

1st. Report

Completion FEB 20 1952

Remarks

Sunflower Drlg. - Contr.

Spudding Date 1-17-52

Drlg. Data Oil well TD 1658

8" @ 351 Miss. 1623 5" @ 1630

TD 1658 Comp. 8 bopd

J. G. McGEHEE