


Section 21 Township 23 Range 14E

Well No. #1 Shrimplin

Company R. E. French

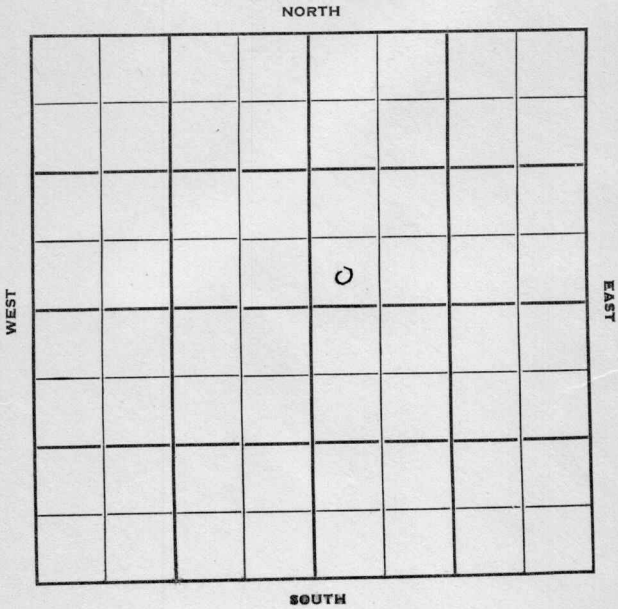

Sec. 21 Twp. 23 R. 14E ✓

Well No. #1 Shrimplin Farm

R. E. French Company

Contractor


Ft. from N. Line

330' Ft. from S. Line

Ft. from E. Line

330' Ft. from W. Line

SW SW NE

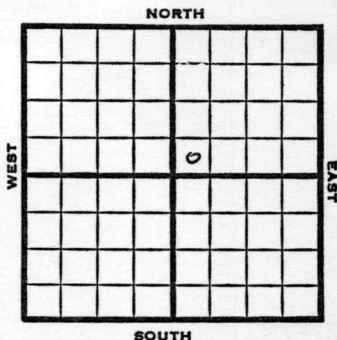

1951	REPORT
8/8	Spud 8-4-51
	Drlg. 150'
9/5	Oil Well TD 1685'
	10" @ 468
	Miss. ch. 1669-70
	Miss. lime 1670-76
	TD 1685 5" @ 1674
	Comp. 9 BOPD
	COMPLETED

County Woodson State Kansas

Sec. **21** (Blk.) **23** (Sur.) **14E** Map No.

Operator R. E. French

Well No. **1** Farm **Shrimplin**

Elev.	Location	SW SW NE
-------	----------	-----------------

FIRST REPORT

330 Ft. From S Line NE

330 Ft. From W Line Quarter

1st. Report AUG 8 1951

Completion _____

Remarks

Spudding Date 8-4-51

Drlg. Data

drlg. 150

J. E. TYRA

County Woodson State KansasSec. 21 (Blk.) 23 (Sur.) 14E Map No.Operator R. E. FrenchWell No. 1 Farm ShrimplinElev. Location SW SW NE330 Ft. From S Line NE330 Ft. From W Line Quarter1st. ReportCompletion SEP 5 1951RemarksSpudding Date 8-4-51Drlg. Data Oil well TD 168510" @ 468 Miss. ch. 1669-70 Miss. lime1670-76 TD 1685 5" @ 1674Comp. 9 bopd

J. E. TYRA