


Map No. _____ Sec. 21 Twp. 27 R. 4
Well No. 10 Deal Farm
Magnolia Company
NORTH

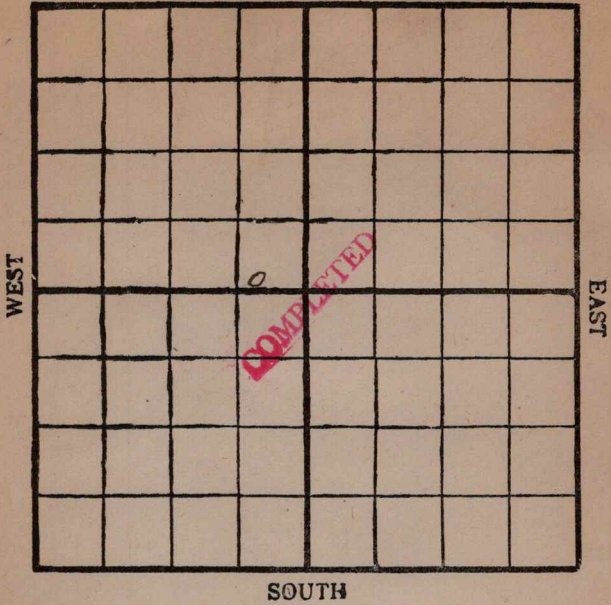

Location _____	Rig Up _____
Drilling Remarks: _____	Drilling Remarks: _____
RECORD	PRODUCTION
Cased _____ in. _____ ft.	1st 24 hrs. Nat. _____
Sand _____	1st 24 hrs. after shot _____
Gas _____	Gas _____ cu. ft.
Oil _____	Dry Hole _____
Total Depth _____	Abandoned _____

Map No. 511 Sec. 21 Twp. 27 R. 4Well No. 10 DeepMagnolia Company

Contractor

NORTH

WEST

EAST

SOUTH

Location _____

Rig up ☒

Drilling and Remarks:

RECORD

Cased _____ in., _____ ft.

Sand _____

Gas _____

Oil _____

Total Depth _____

PRODUCTION

1st 24 hrs. Nat. _____

1st 24 hrs. after shot _____

Gas _____ Cu. Ft.

Dry Hole _____

Abandoned _____

FIRST REPORT

Date

191

9

Conley

Scout


Contractor

NORTH

WEST

EAST

SOUTH

200 S 430 E

Location _____

Rig up ☒

Drilling and Remarks:

RECORD

Cased _____ in., _____ ft.

Sand _____

Gas _____

Oil _____

Total Depth _____

PRODUCTION

1st 24 hrs. Nat. _____

1st 24 hrs. after shot _____

Gas _____ Cu. Ft.

Dry Hole _____

Abandoned _____

Date

1/23 191 9 Conley Scout

Map No. K 11 Sec. 21 Twp. 27 R. 4Well No. 10 DealMagnolia Company

Contractor

NORTH

WEST

EAST

			0				

SOUTH

430 E200 S.

Location

Rig up

Drilling and Remarks:

RECORD

Cased _____ in., _____ ft.

Sand _____

Gas _____

Oil _____

Total Depth _____

PRODUCTION

1st 24 hrs. Nat. _____

1st 24 hrs. after shot _____

Gas _____ Cu. Ft.

Dry Hole _____

Abandoned _____

Date

3/8 1919

Pyle


Scout

Map No. K 11 Sec. 21 Twp. 27 R. 4
 Well No. 10 Deal
Magnolia Pet. Company
 Contractor

NORTH

WEST

EAST

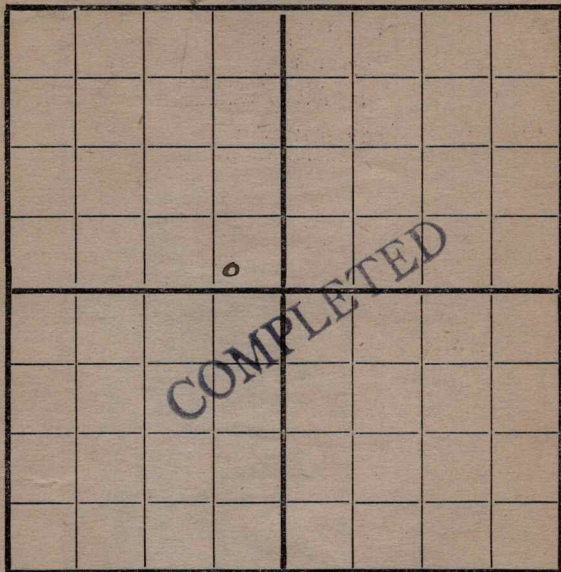

2005

SOUTH

430 E

Location _____

Rig up _____

Drilling and Remarks:

RECORD

Cased _____ in., _____ ft.

Sand _____

Gas _____

Oil 1928-1955Total Depth 1976

PRODUCTION

1st 24 hrs. Nat. 25 bbls

1st 24 hrs. after shot _____

Gas _____ Cu. Ft.

Dry Hole _____

Abandoned _____

Date

4
23
 1919

Pyle

Scout