


Section 21 Township 23 Range 14E

Well No. #6 Shrimplin

Company R. E. French

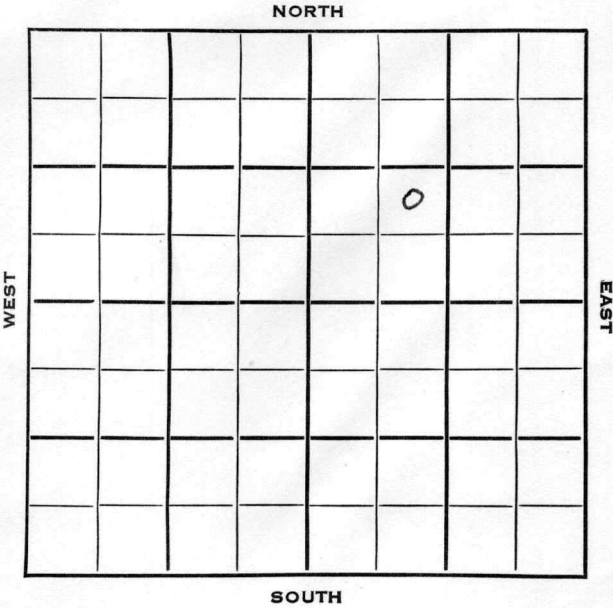


Woodson

KANSAS ✓

Sec. 21 Twp. 23 R. 14 EWell No. # 6 Shrimplin FarmR. E. French CompanyBrown ContractorWintersheid Pool Ft. from N. Line990 Ft. from S. Line Ft. from E. Line990 Ft. from W. Line

NE SW NE

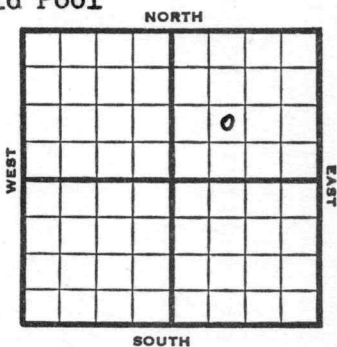

1953

Elev. -

REPORT

8/19

Spud 8-10-53

8" @ 835'

Drlg. 840'

9/2

Spud 8-10-53

Oil Well

TD 1680'

8" @ 835'

Miss 1651

TD 1676'

PB 1664

5" @ 1664'

DD 1680

2000 A S/ $\frac{1}{2}$ boph

Comp. 5 bopd.

COMPLETED

County Woodson State Kansas
 Sec. 21 (Blk.) 23 (Sur.) 14E Map No.
 Operator R. E. French
 Well No. 6 Farm Shrimplin
 Elev. Location NE SW NE

990 Ft. From S Line NE

990 Ft. From W Line Quarter

1st. Report

SEP 2 1953

Completion

Remarks Wintersheid Pool

Brown - Contr.

Spudding Date 8-10-53

Drilg. Data Oil well TD 1680

8" @ 835 Miss. 1651 TD 1676

PB 1664 5" @ 1664 DD 1680 2000 A

S/ $\frac{1}{2}$ boph Comp. 5 bopd

J. G. McGEHEE