

Map No. 144 Sec. 36 Twp. 27 R. 10

Well No. 4 Mock Farm

Ward Mc Ginnis Company

NORTH

WEST

EAST

SOUTH

Location _____

Drilling Remarks

Rig Up

Drilling Remarks

RECORD

Cased _____ in. _____ ft.

Sand

Gas _____

Oil _____

Total Depth.....

PRODUCTION

1st 24 hrs. Nat.-----

1st 24 hrs. after shot_____

Gas_____cu. ft.

Dry Hole _____


Abandoned -----

Map No. Greenwood Sec. 36 Twp. 24 R. 10Well No. 425 snock FarmWard m c Ginnis Company990 Ft. from N. Line

Ft. from S. Line

990 Ft. from E. Line

Ft. from W. Line

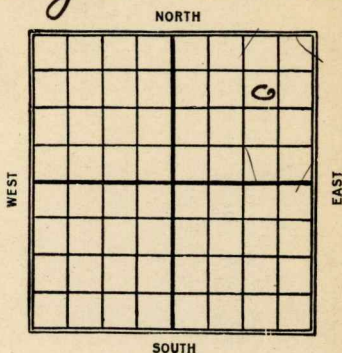1926

Date

REPORT

9/22 Location
9/29 Bldg rig
10/3 rigging up
10/27 Drilg 9150'
11/11 Sand 1873-1897'
Oil 1880, shale 1897-1903
Sdy shale 1905-1912
100/200 bbls

Greenwood
 Map No. **16 KANSAS** Sec. **36** Twp. **24** R. **10**
 Well No. **4** *Mock*
Hard the Sinner Company

Contractor

FIRST REPORTS**SECTION PLAT**

			0

990 Ft. from N. Line

Ft. from S. Line

990 Ft. from E. Line

Ft. from W. Line

Location ☒

Rig up

Drilling and Remarks:

RECORD

Cased _____ in., _____ ft.

Sand _____

Gas _____

Oil _____

Total Depth _____

PRODUCTION

1st 24 hrs. Nat. _____

1st 24 hrs. after shot _____

Gas _____ Cu. Ft.

Dry Hole _____

Abandoned _____

Date **SEP. 22, 1926**

CHAS. L. SHERWOOD

192

Scout

16 **KANSAS** 36 Twp. 24 R. 10
 Map No. Sec. Twp. R.

Well No. 2 Mock
 Ward Mc Sinner Company

Contractor

CORRECTION**SECTION PLAT**

990


Ft. from N. Line

Ft. from S. Line

990

Ft. from E. Line

Ft. from W. Line

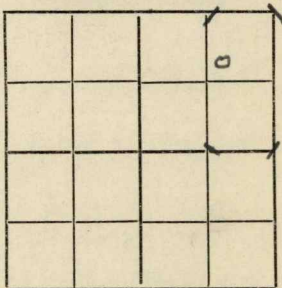

Location

Rig up

Drilling and Remarks:

Drly 1150
 previously reported
 as #4. chg to #2.

RECORD

Cased in., ft.

Sand

Gas

Oil

Total Depth

PRODUCTION

1st 24 hrs. Nat.

1st 24 hrs. after shot

Gas Cu. Ft.

Dry Hole

Abandoned

Date

OCT 27 1926

192

CHAS. L. SHERWOOD

Scout

16 **KANSAS** *36* Sec. *24* Twp. *10* R.

Well No. *2* *Mock*

Ward Mc Ginnis Company

Contractor

COMPLETED

SECTION PLAT

990 Ft. from N. Line

Ft. from S. Line

990 Ft. from E. Line

Ft. from W. Line

			<i>0</i>

Location

Rig up

Drilling and Remarks:

Sand 1873-1897'

oil 1880'

shale 1897-1905

sdv shale 1905-1912

100y 200 lbs

RECORD

Cased _____ in., _____ ft.

Sand _____

Gas _____

Oil _____

Total Depth *1912*

PRODUCTION

1st 24 hrs. Nat. _____

1st 24 hrs. after shot _____

Gas _____ Cu. Ft.

Dry Hole _____

Abandoned _____

Date

NOV 11 1926

192

CHAS. L. SHERWOOD

Scout