

WEST

EAST

SOUTH

Drilling Remarks

Drilling Remarks

RECORD

Cased _____ in. _____ ft.

Sand

Gas

Oil

Total Depth

PRODUCTION

1st 24 hrs. Nat.-----

1st 24 hrs. after shot_____

Gas_____cu. ft.

Dry Hole _____

Abandoned

Map No. Kans Sec. 36 Twp. 24 R. 10


Well No. 3 Snock Farm
Ward McGinnis Company

330 Ft. from N. Line

_____ Ft. from S. Line

990 Ft. from E. Line

_____ Ft. from W. Line

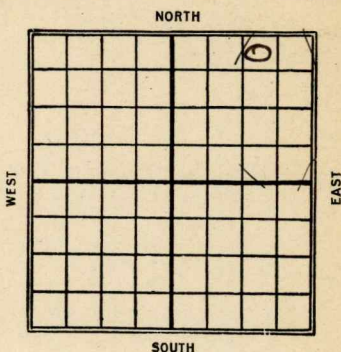

1926

Date

REPORT

9/22 Location

9/29 timber

10/13

10/27 Oil 650'

11/10 sand 1873-1899

100/150 bbb

16 **KANSAS** 36 Twp. 24 R. 10
 Map No. Sec. Twp. R.
 Well No. 3 Mocks
 Ford Mc Ginnis Company

Contractor

FIRST REPORTS**SECTION PLAT**

220

Ft. from N. Line

Ft. from S. Line

990

Ft. from E. Line

Ft. from W. Line

			0

Location ✓

Rig up

Drilling and Remarks:

RECORD

Cased _____ in., _____ ft.

Sand _____

Gas _____

Oil _____

Total Depth _____

PRODUCTION

1st 24 hrs. Nat. _____

1st 24 hrs. after shot _____

Gas _____ Cu. Ft.

Dry Hole _____

Abandoned _____

(Date

SEP 22 1926

192

CHAS. L. SHERWOOD

Scout

16 **KANSAS** Sec. 36 Twp. 24 R. 10

Well No. 3 Mock
Ward Mc Ginnis Company

Contractor

COMPLETED

SECTION PLAT

			0

330 Ft. from N. Line

Ft. from S. Line

990 Ft. from E. Line

Ft. from W. Line

Location

Rig up

Drilling and Remarks:

100
150 bbls

RECORD

Cased in., ft.

Sand 1873-1899

Gas

Oil

Total Depth 1899

PRODUCTION

1st 24 hrs. Nat.

1st 24 hrs. after shot

Gas Cu. Ft.

Dry Hole

Abandoned

Date

NOV 1 1 1926

192

CHAS. L. SHERWOOD

Scout