


KANSAS
Map No. 15 Sec. 36 Twp. 24 R. 10E
Well No. 5-Mock Farm
Ward McGinnis Company

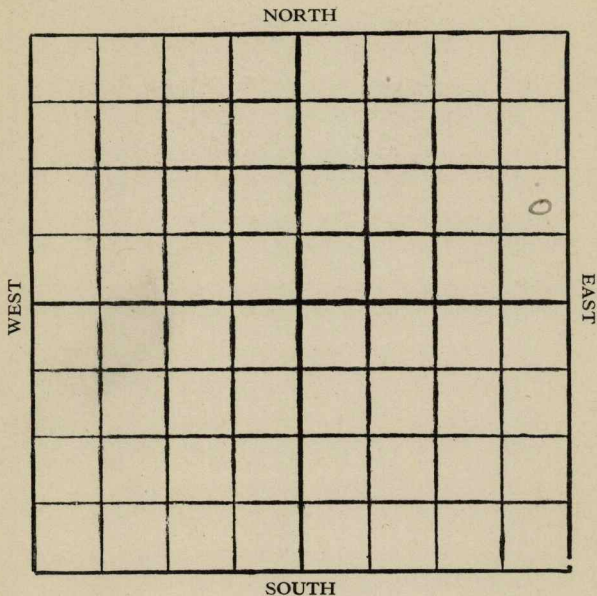

Location

Drilling Remarks

Rig Up

Drilling Remarks

RECORD

Cased in. ft.

Sand

Gas

Oil

Total Depth

PRODUCTION

1st 24 hrs. Nat.

1st 24 hrs. after shot

Gas cu. ft.

Dry Hole


Abandoned

Greenwood

KANSAS

Map No. Kansas Sec. 36 Twp. 24 R. 10Well No. 5 mock FarmWard Mc Ginnis Company

NORTH

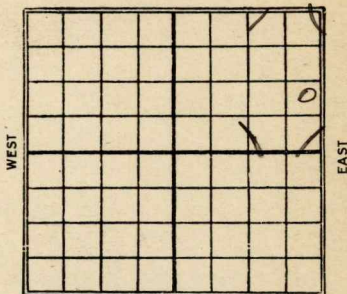

Ft. from N. Line

990 Ft. from S. Line330 Ft. from E. Line

Ft. from W. Line

Date

REPORT

19271/12

R.O.G.

1/19

Bldg rig

1/26

Rig

2/3

same

2/10

spudding

2/172/243/23/93/163/24

Spudded + S.D.

3/304/74/134/204/275/55/125/185/256/16/76/15

6/29	Spudded + S.D.	
7/7		4/19
7/13		4/16
7/20		5/3
7/28		5/10
8/4		5/8
8/10		5/14
8/18		5/31
8/24		6/7
9/1		6/14
9/7		6/21
9/14		6/28
9/29		7/6
10/6		7/13
10/12		7/19
10/19		7/26
10/27		8/2
11/2		8/9
11/9		8/16
11/16		8/23
11/23		8/28
11/30		9/4
12/7		9/12
12/14		9/19
12/21		9/26
12/29		10/3
1928		10/10
1/5		10/17
1/11		10/24
1/18		10/31
2/6		11/7
2/12		11/14
2/19		11/21
2/26		11/28
3/5		12/5
3/12		12/12
3/19		12/19
		12/26
		1929
		1/2
		1/9
		1/16


Spudded + S.D.

1929

Abandon location

Greenwood

 16 KANSAS Map No. Sec. 36 Twp. 24 R. 10^E

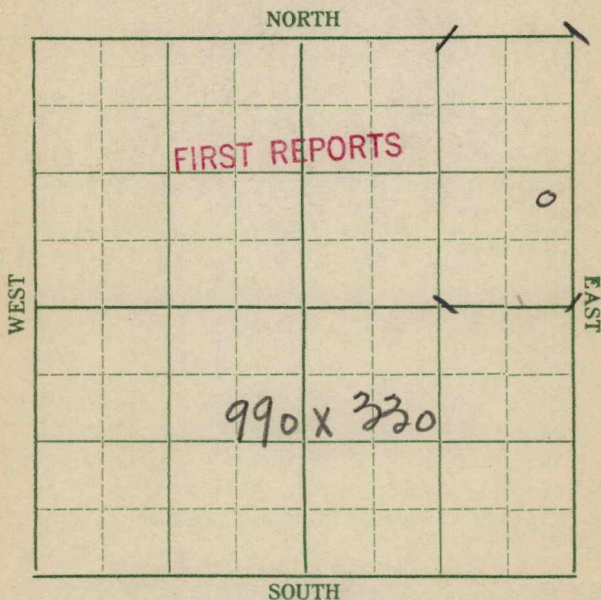 Well No. 5 Mock Farm
 Ward Mc Sinner Company

 Location R.O. 5
 Rig up
 Drilling and Remarks:

RECORD

 Cased _____ in., _____ ft.
 Sand _____
 Gas _____
 Oil _____
 Total Depth _____

PRODUCTION

 1st 24 hrs. Nat. _____
 1st 24 hrs. after shot _____
 Gas _____ Cu. Ft.
 Dry Hole _____
 Abandoned _____

 Date
 JAN 12 1927

192

CHAS. L. SHERWOOD

Scout

Map No. **KANSAS** Sec. **36** Twp. **24** R. **10**
 Well No. **5** **Mock**

Ward Mc Ginnis Company

Contractor

COMPLETE

SECTION PLAT

			0

Ft. from N. Line

990 Ft. from S. Line

330 Ft. from E. Line

Ft. from W. Line

ABANDONED

Location

Rig up

Drilling and Remarks:

RECORD

Cased in., ft.

Sand

Gas

Oil

Total Depth

PRODUCTION

1st 24 hrs. Nat.

1st 24 hrs. after shot

Gas Cu. Ft.

Dry Hole

Abandoned

Date

MAY 22 1929

192

CHAS. L. SHERWOOD

Scout