


Section 21 Township 23 Range 14 EWell No. # 1 Schrimplin *Peek-KGS DRL*Company R. E. French

NORTH

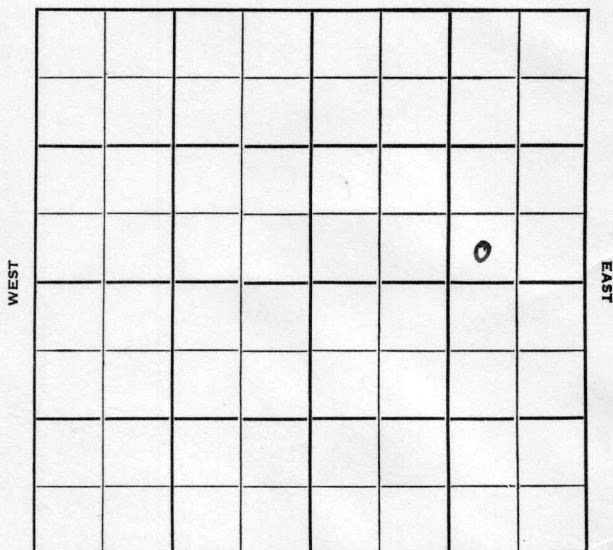

SOUTH

Sec. 21 Twp. 23 R. 14E

Well No. #4 Schrimplin Farm

R. E. French Company

Contractor


Ft. from N. Line

330 Ft. from S. Line

990 Ft. from E. Line

Ft. from W. Line

App. SW SE NE

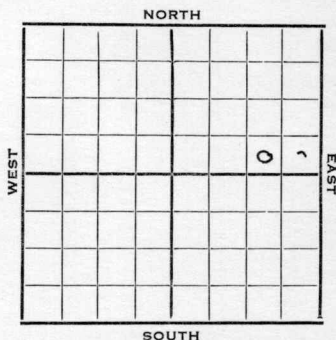

1952

Elev. -

REPORT

8/20

Spud 8-8-52

8" @ 830'

Drlg. 1130'

9/17

Spud 8-8-52

Oil well TD 1690' 8" @ 830'

7" @ 1225 Miss ch. 1650'


Miss lime 1652' TD 1690'

5" @ 1654 2000 A

Comp. 15 BOPD

COMPLETED

County **Woodson** State **Kansas**
 Sec. **21** (Blk.) **23** (Sur.) **14E** Map No.
 Operator **R. E. French**
 Well No. **4** Farm **Schrimplin**
 Elev. Location **App SW SE NE**

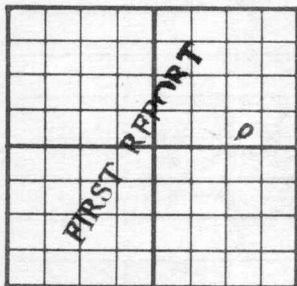

330 Ft. From **S** Line **NE**
990 Ft. From **E** Line Quarter

1st. Report **AUG 20 1952**

Completion


Remarks

Spudding Date **8-8-52**

Drlg. Data

8" @ 830 Drlg. 1130

J. G. McGEHEE

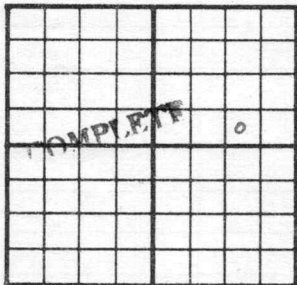County Woodson State KansasSec. 21 (Blk.
Twp.) 23 (Sur.
Rge.) 14E Map No.Operator R. E. FrenchWell No. 4 Farm SchrimplinElev. Location SW SE NE330 Ft. From S Line NE990 Ft. From E Line Quarter1st. ReportCompletion SEP 17 1952RemarksSpudding Date 8-8-52Drlg. Data Oil well TD 16908" @ 830 7" @ 1225 Miss. ch. 1650Miss. lime 1652 TD 1690 5" @ 16542000 A Comp. 15 bopd

J. G. McGEHEE

Woodson

KANSAS
11E

Sec. 21 Twp. 23 R. 11E

Well No. #4 Peek Farm

R.E. French

Company

Contractor

*Duplicate
original in completed
files*

330


Ft. from S. Line

990

Ft. from E. Line

Ft. from W. Line

SW SE NE

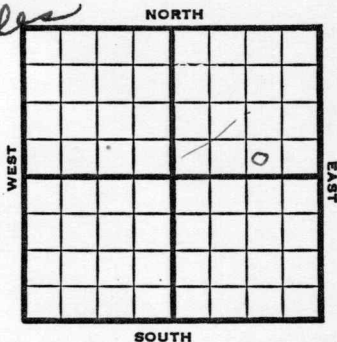

1952

REPORT

10/1

Spud 8-8-52
Oil Well TD 1674'
8" @ 830'
Miss. 1652'
5" @ 1654' TD 1674' 2000A
P. 77 bopd Dec. to 16 bopd
Complete

FIRST REPORT
+
COMPLETED

County Woodson State KANSASSec. 21 (Blk. 23 (Sur. 14E (Twp.) (Rge.) Map No.Operator R. E. FrenchWell No. 4 Farm PeekElev. Location SW SE NE

FIRST REPORT

6

COMPLETE

Duplicate

330 Ft. From S Line NE990 Ft. From E Line Quarter1st. Report OCT 1 1952Completion OCT 1 1952Remarks DuplicateSpudding Date 8-8-52Drlg. Data Oil well TD 16748" @ 830 Miss. 1652 5" @ 1654TD 1674 2000 A P/ 77 bopddec. to 16 bopd Comp.

original
in
completed
files

Is this a OWWO, duplicate ticket
on #4 Schrimplin or a Twin well?

LR

OCT 20 1952

Scout Cards	<i>mm</i>
Land Small Map	
Land Wall Map	<i>3</i>
Tracings	
France Map	
Pierce Map	
Misc	

OCT 2 1952

Orig. Data