


Section 1 Township 23 Range 16E

Well No. #3 Meats

Company Chas. Hardesty

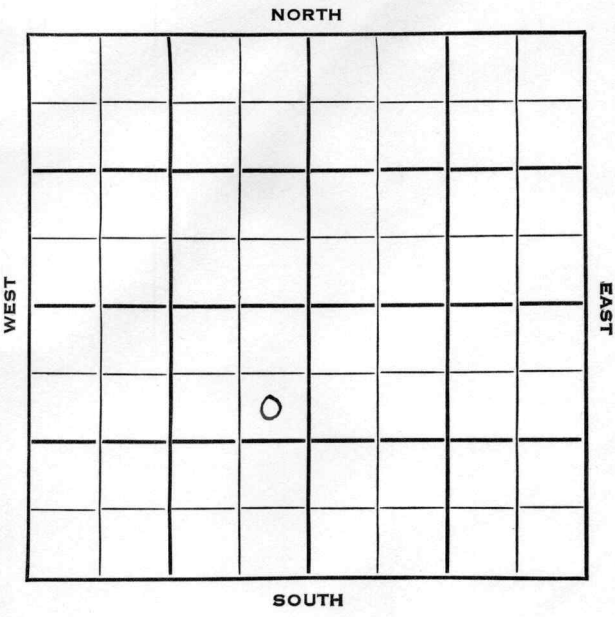

Coffey

KANSAS

SEC.	TWP.	R.
1	23	16E ✓

WELL NO.

3 Meats

FARM

COMPANY

Chas. Hardesty

CONTRACTOR

McLoflin

LeRoy Pool


990 Ft. from N. Line

Ft. from S. Line

330 Ft. from E. Line

Ft. from W. Line

SE NE SW

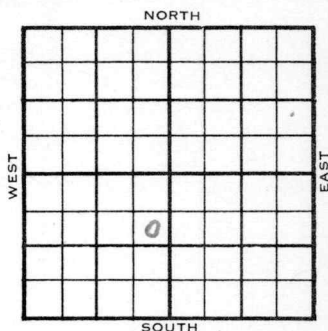

1953

ELEVATION

REPORT

9/30

Spud 9-23-53

10" @ 32'

B/5 bwph 522-27

7" @ 619' HFW

Drlg. 860'

11/11

Spud 9-23-53 Oil well TD 960

10" @ 32 B/5 BWPH 522-27 7" @ 619

sd-frac. Sqz sd 947' TD 960

Sd-frac. 5" @ 948

Comp. 25 BOPD

COMPLETED

County Coffey State Kansas
 Sec. 1 (Blk.) 23 (Sur.) 16E Map No.
 Operator Chas. Hardesty
 Well No. 3 Farm Meats
 Elev. _____ Location SE NE SW

FIRST REPORT

0

990 Ft. From N Line SW
330 Ft. From E Line Quarter
 1st. Report SEP 30 1953
 Completion _____
 Remarks _____
McLoflin - Contr.
 Spudding Date 9-23-53

Drlg. Data LeRoy Pool
10" @ 32 B/ 5 bwph 522-27 7" @ 619 H7W
drlg. 860

sdfrac 5" @ 948 Comp. 25 bopd

J. G. McGEHEE