


Section 13 Township 23 Range 16E

Well No. #2 Murray

Company Susmio Oil

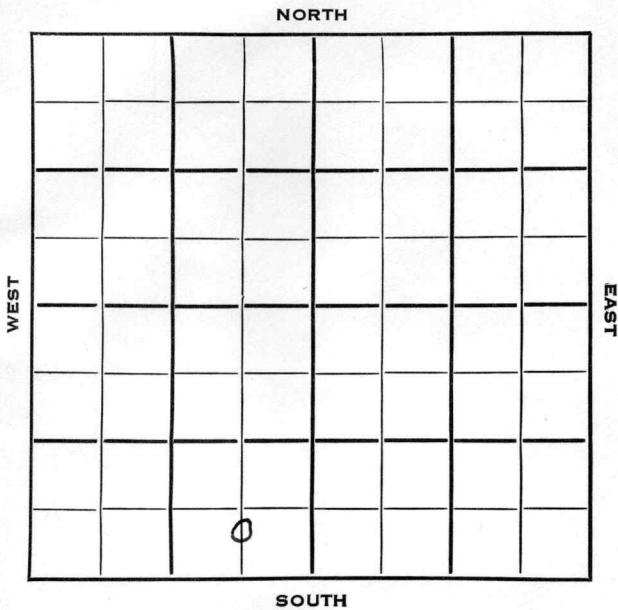

Coffey

KANSAS

SEC.

TWP.

R.

13

23

16E

WELL NO.

2 Murray

FARM

COMPANY

Susmio Oil

CONTRACTOR

Chapman

LeRoy Pool


Ft. from N. Line

Ft. from S. Line

Ft. from E. Line

Ft. from W. Line

C N/2 S/2 SE SW

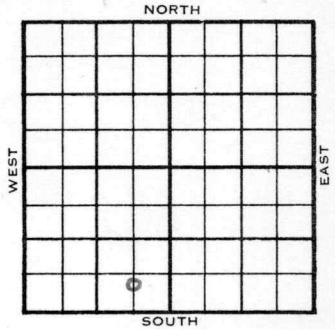

1953

ELEVATION


REPORT

9/30

Oil Well
Gas sd 930
sq. sd 936-64 TD
5" @ 938'
CO to 959
d-frac
P/8 boph
P/420 bo 24 hrs.
Comp. 35 bopd

FIRST REPORT

COMPLETED

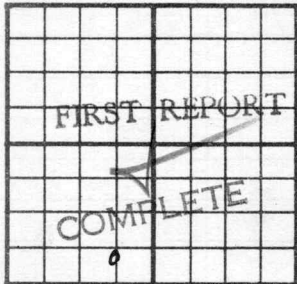County Coffey State KansasSec. 13 (Blk. 23 (Sur. 16E Map No. 13) (Twp. 23 (Rge. 16E)Operator Susmie OilWell No. 2 Farm MurrayElev. Location C N $\frac{1}{2}$ S $\frac{1}{2}$ SE SW480 Ft. From S Line SW660 Ft. From E Line Quarter1st. Report SEP 3 0 1953Completion SEP 3 0 1953Remarks Chapman - Contr.Spudding Date Drig. Data Oil well TD 964 LeRoy PoolGas sd. 930 Sq. sd. 936-64 TD 5" @ 938C0 to 959 sd-frac P/ 8 boph P/ 420 bo24 hr. Comp. 35 bopd