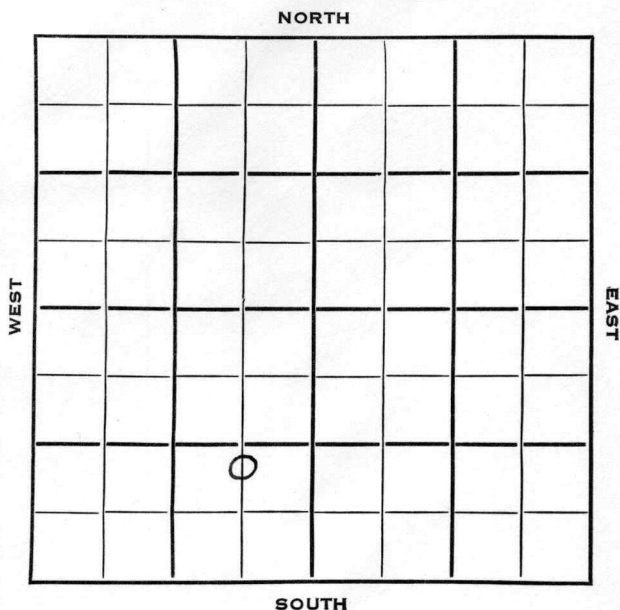


Section 13 Township 23 Range 16EWell No. #3 MurrayCompany Susmio Oil

Coffey		KANSAS
SEC. 13	TWP. 23	R. 16E
WELL NO. 3 Murray		
COMPANY Susmio Oil		FARM
CONTRACTOR Chapman		
LeRoy Pool		


_____ Ft. from N. Line

1120 _____ Ft. from S. Line

660 _____ Ft. from E. Line

_____ Ft. from W. Line

N/2 N/2 SE SW

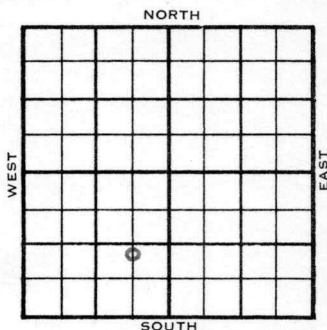

1953	ELEVATION	REPORT
9/30	Oil Well TD 960' Sq. sd 936-60 TD 960' 5" @ 939' CO to 955 Sd-frac S/200 bo 8 hrs. Comp. 35 bopd	FIRST REPORT COMPLETED

County Coffey State Kansas
 Sec. 13 (Blk.) 23 (Sur.) 16E Map No.
 Operator Susmio Oil
 Well No. 3 Farm Murray
 Elev. _____ Location N $\frac{1}{2}$ N $\frac{1}{2}$ SE SW



1120 Ft. From S Line SW
660 Ft. From E Line Quarter
 1st. Report SEP 30 1953
 Completion SEP 30 1953

Remarks _____

Chapman - Contr.

Spudding Date _____

Drlg. Data Oil well TD 960 LeRoy Pool
Sq. sd. 936-60 TD 960 5" @ 939
CO to 955 sd-frac S/ 200 bo 8 hr.
Comp. 35 bopd

J. G. McGEHEE