


Section 13 Township 23 Range 16E

Well No. #4 Murray

Company Susmio Oil

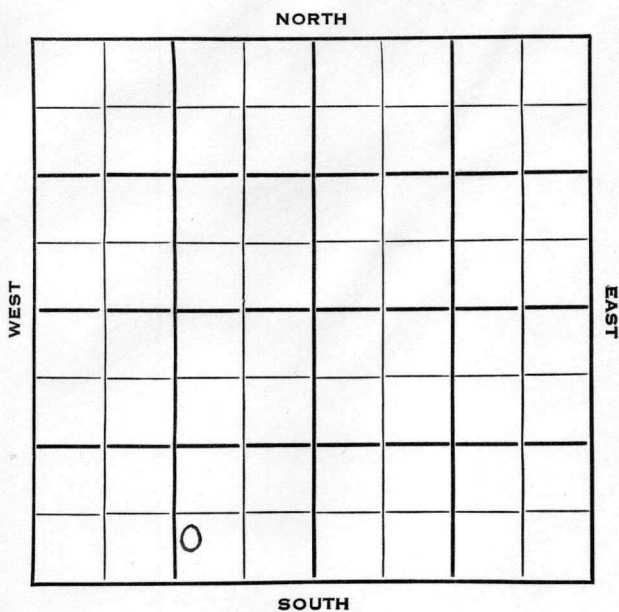

Coffey

KANSAS

SEC.	TWP.	R.
13	23	16E ✓

WELL NO.

#4 Murray

FARM

COMPANY

Susmio Oil

CONTRACTOR

Chapman

LeRoy Pool


NORTH

Ft. from N. Line

Ft. from S. Line

Ft. from E. Line

Ft. from W. Line

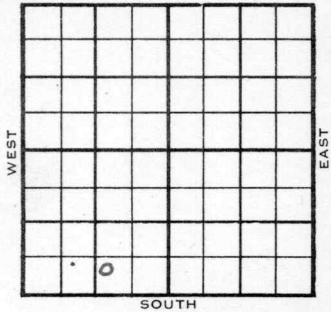


NW SW SE SW

1953	ELEVATION	REPORT
9/20	10" @ 33' 8" @ 174' 7" @ 564' Sq. sd 950-54 TD 972' 5" @ 950' CO to 954' sd-frac	
10/7	Oil Well TD 972' 10" @ 33' 8" @ 174', 7" @ 564' TD 972' 5" @ 950' Squirrel Sd 950-54' TD 972' CO to 954' sd-frac Comp 35 bopd.	

COMPLETED

J. G. McGEHEE

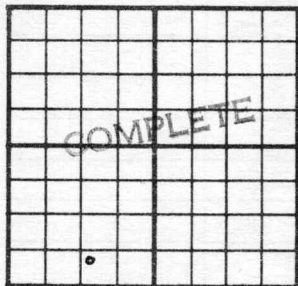County Coffey State KansasSec. 13 (Blk. 23) (Sur. 16E) Map No. 16EOperator Susmio OilWell No. 4 Farm MurrayElev. Location NW SW SE SW480 Ft. From S Line SW1000 Ft. From E Line Quarter1st. ReportCompletion OCT 7 1953Remarks LeRoy PoolChapman - Contr.Spudding DateDrlg. Data Oil well TD 97210" @ 33 8" @ 174 7" @ 564squirrel sd. 950-54 TD 972 5" @ 950CO to 954 sd-frac Comp. 35 bopd