

Coffey


FORM 51

KANSAS

Section 13 Township 23 Range 16E

Well No. #6 Murray

Company Susmio

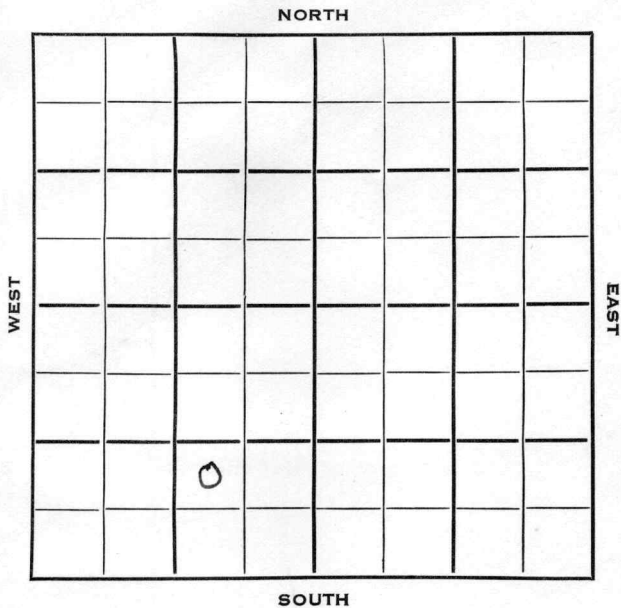

Coffey

KANSAS

SEC.	TWP.	R.
13	23	16E ✓

WELL NO.

#6 Murray

FARM

COMPANY

Susmio


CONTRACTOR

Ft. from N. Line

1100 Ft. from S. Line

1100 Ft. from E. Line

Ft. from W. Line

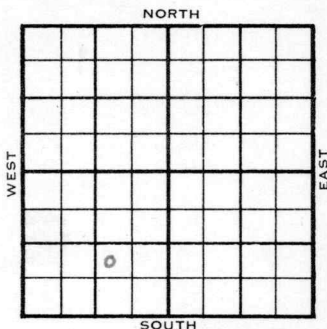

NW SE SW

ELEVATION

REPORT

1953

--

10/7

Spud 10-1-53

10" @ 37'

8" @ 167'

Drlg 450'

12/9

Spud 10-1-53

Oil Well

TD 964'

10" @ 37'

8" @ 167'

Sq. sd 1956'

TD964

5" @ 954

TD 963

SP 956

Hydrofr c

CO to 964

Sd-frac

Comp. 18 bopd

COMPLETED

County Coffey State KansasSec. 13 (Blk. Twp.) 23 (Sur. Rge.) 16E Map No.Operator SusmioWell No. 6 Farm MurrayElev. Location NW SE SW

FIRST REPORT

1100 Ft. From S Line SW1100 Ft. From E Line Quarter1st. Report OCT 7 1953

Completion

Remarks

Spudding Date 10-1-53

Drlg. Data

10" @ 37 8" @ 167 drlg. 450

J. G. McGEHEE

