

Coffey


FORM 51

KANSAS

Section 13 Township 23 Range 16E

Well No. #1 Murray

Company Susmio Oil

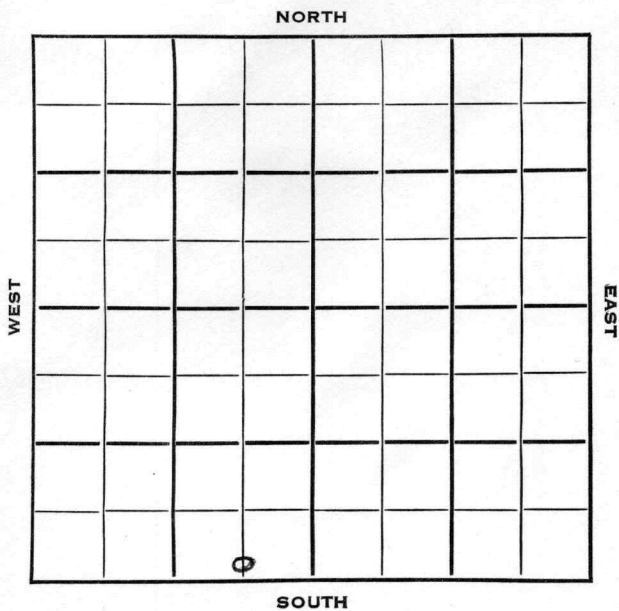

Coffey KANSAS ✓
SEC. 13 TWP. 23 R. 16E

WELL NO.

1 Murray

FARM

COMPANY

Susmio Oil

CONTRACTOR

Chapman

LeRoy Pool


_____ Ft. from N. Line

40 _____ Ft. from S. Line

660 _____ Ft. from E. Line

_____ Ft. from W. Line

C S/2S/2 SE SW

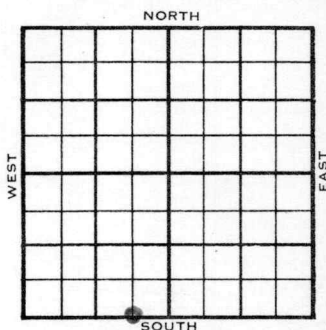

1953

ELEVATION

REPORT

9/30

Oil Well

TD 960'

Sq. sd 936-60

5" @ 939'

PB 954

Sd-frac S/220 bo 24 hrs.

Comp. 35 bopd

FIRST REPORT

✓
COMPLETED

