


Coffey KANSAS

Section 14 Township 23 Range 16 E

Well No. # 1 Beard

Company Susmic Oil

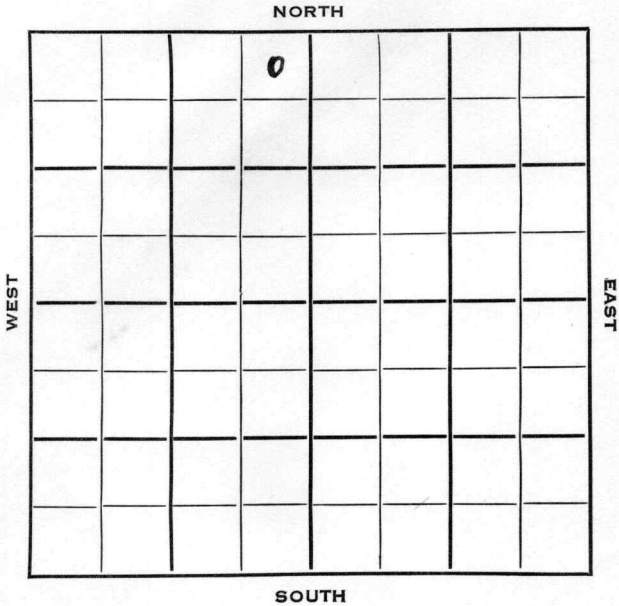

Coffey

KANSAS ✓


Sec. 14 Twp. 23 R. 16EWell No. #1 Beard FarmSusmio Oil CompanySusmio Contractor330 Ft. from N. Line

Ft. from S. Line

330 Ft. from E. Line

Ft. from W. Line

NE NE NW

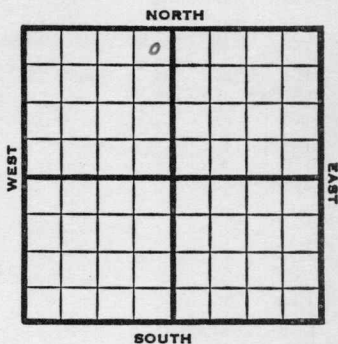

1953

Elev. -

REPORT

7/14

Spud 7-9-53

10" @ 30'

8" @ 153'

Drlg 625'

8/5

Spud 7-9-53

Oil Well

TD 968'

10" @ 30'

8" @ 153'

5" @ 955'

sq. sd 951

Comp. 17 bopd.

COMPLETED

County **Coffey** State **Kansas**Sec. **14** (Blk.) **23** (Sur.) **16E** Map No.Operator **Susmio Oil**Well No. **1** Farm **Beard**Elev. Location **NE NE NW**

FIRST REPORT

330 Ft. From **N** Line **NW****330** Ft. From **E** Line Quarter1st. Report **JUL 14 1953**

Completion

Remarks

Susmio-Contr.Spudding Date **7-9-53**

Drlg. Data

10" @ 30 8" @ 153 Drlg. 625**J. G. MCGEEHEE**

County Coffey State Kans.Sec. 14 (Blk.) 23 (Sur. Rge.) 16E Map No.Operator Susmio OilWell No. 1 Farm BeardElev. Location NE NE NW

			0			

330 Ft. From N Line NW330 Ft. From E Line Quarter

1st. Report

Completion AUG 5 1953

Remarks

Susmio - Contr.Spudding Date 7-9-53Drlg. Data Oil well TD 96810" @ 30 8" @ 153 5" @ 955 sq. sd. 951Comp. 17 bopd