


KANSAS

Map No. _____ Sec. 27 Twp. 23 R. 17
Well No. 1-Gardner Farm _____
Big Indian Oil Company

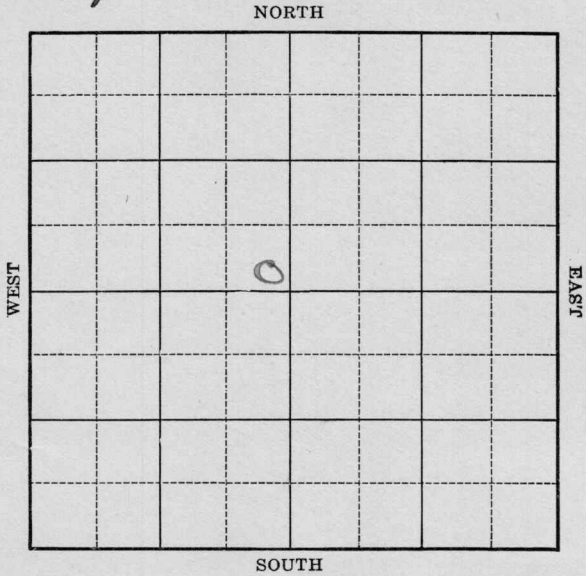

Location _____
Drilling Remarks _____

Rig Up _____
Drilling Remarks _____

RECORD

Cased _____ in. _____ ft.
Sand _____
Gas _____
Oil _____
Total Depth _____

PRODUCTION

1st 24 hrs. Nat. _____
1st 24 hrs. after shot _____
Gas _____ cu. ft.
Dry Hole _____
Abandoned _____

KANSAS

Map No. _____ Sec. 27 Twp. 23 R. 17

Well No. 1 - Gardner Farm
Big Indian oil Company
NORTH


NORTH

-----Ft. from N. Line

200 Ft. from S. Line

200 Ft. from E. Line

Ft. from W. Line

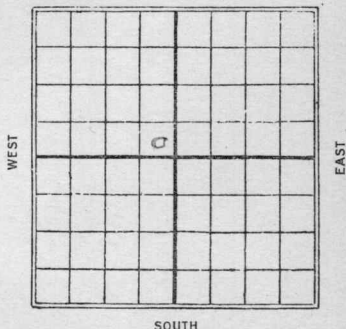

1928

Date _____

REPORT

4/19 Hrlg 400'

4/26	"J	750
------	----	-----

5/3 " 750

5/10 Top line 1216

Q. & A. 1272

Woodson
 no KANSAS
 Map No. 27 Sec. 73 Twp. 17 R. 17 ^E
 Well No. 1 Sardner
Big Indian Oil Co Company
 Contractor

FIRST REPORTS

_____ Ft. from N. Line
200 Ft. from S. Line
200 Ft. from E. Line
 _____ Ft. from W. Line

SECTION PLAT

Location _____

Rig up _____

Drilling and Remarks:

dy 400'

RECORD

Cased _____ in., _____ ft.

Sand _____

Gas _____

Oil _____

Total Depth _____

PRODUCTION

1st 24 hrs. Nat. _____

1st 24 hrs. after shot _____

Gas _____ Cu. Ft.

Dry Hole _____

Abandoned _____

Date

APR 19 1928

192

CHAS. L. SHERWOOD

Scout

no tracing
KANSASMAP NO. _____ SEC. 27 TWP. 23 R. 17WELL NO. 1Gardner
Big Indian Oil Co COMPANY

CONTRACTOR

COMPLETED

SECTION PLAT

_____ FT. FROM N. LINE

200 FT. FROM S. LINE200 FT. FROM E. LINE

_____ FT. FROM W. LINE

ABANDONED

RECORD

LOCATION _____

CASED _____ IN. _____ FT.

RIG UP _____

SAND _____

DRILLING AND REMARKS:

GAS _____

OIL _____

TOTAL DEPTH 1272

PRODUCTION

1ST 24 HRS. NAT. _____

1ST 24 HRS. AFTER SHOT _____

GAS ✓ _____ CU. FT.DRY HOLE ✓ _____ABANDONED ✓ _____

DATE

MAY 10 1928

192

CHAS. L. SHERWOOD

SCOUT