


Map No. KANSAS Sec. 29 Twp. 23 R. 16^E
 Well No. 2 Boothwell Farm
O. J. Hurndon Company

NORTH

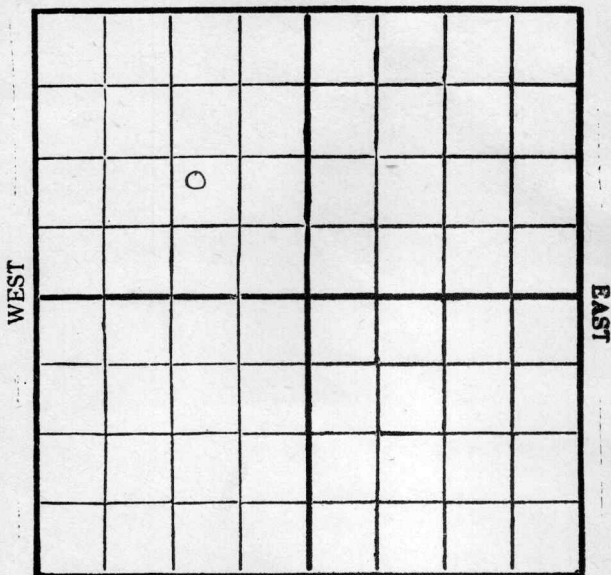

SOUTH

Location _____

Drilling Remarks _____

Rig Up _____

Drilling Remarks _____

RECORD

Cased _____ in. _____ ft.

Sand _____

Gas _____

Oil _____

Total Depth _____

PRODUCTION

1st 24 hrs. Nat. _____

1st 24 hrs. after shot _____

Gas _____ cu. ft. _____

Dry Hole _____

Abandoned _____


Map No. KANSAS Sec. 29 Twp. 23 R. 16^E
Well No. 2- Bathwell Farm
O. J. Furndon Company

_____ Ft. from N. Line

1120 Ft. from S. Line

1120 Ft. from E. Line

_____ Ft. from W. Line

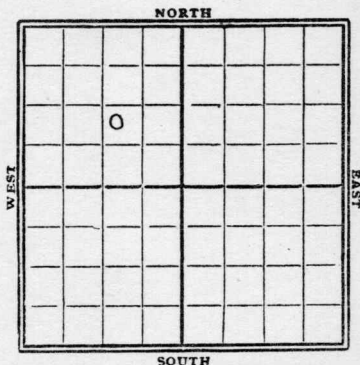

1929

Date

REPORT

7/24 Machine
7/31 Only 600'
8/14 TD 1057'
Dry & Abandoned

KANSAS

Map No. _____ Sec. 29 Twp. 23 R. 16 EWell No. 2 BothwellO.K. Herndon

Company _____

Contractor _____

FIRST REPORTS

SECTION PLAT

_____ Ft. from N. Line

1120 Ft. from S. Line1120 Ft. from E. Line

_____ Ft. from W. Line

	0		

Location _____

Rig up _____

Drilling and Remarks: _____

RECORD

Cased _____ in., _____ ft.

Sand _____

Gas _____

Oil _____

Total Depth _____

PRODUCTION

1st 24 hrs. Nat. _____

1st 24 hrs. after shot _____

Gas _____ Cu. Ft.

Dry Hole _____

Abandoned _____

Date

JUL 24 1929

19

CHAS. L. SHERWOOD

Scout

KANSAS

Map No. _____ Sec. 29 Twp. 73 R. 16Well No. 2 Bathwell0-15 Hendon Company

Contractor

COMPLETE

_____ Ft. from N. Line

1120 Ft. from S. Line1120 Ft. from E. Line

_____ Ft. from W. Line

ABANDONED

SECTION PLAT

Location _____

Rig up _____

Drilling and Remarks:

RECORD

Cased _____ in., _____ ft.

Sand _____

Gas _____

Oil _____

Total Depth 1057

PRODUCTION

1st 24 hrs. Nat. _____

1st 24 hrs. after shot _____

Gas _____ Cu. Ft.

Dry Hole ☒Abandoned ☒

Date

AUG 14 1929

CHAS. L. SHERWOOD

19

Scout